

PROPOSAL REQUEST (PR)



PROJECT NAME ERC Residential Program and PHP		ARCHITECT'S PROJECT NO. 132258.00
PR NO. 09		FILE CODE G1-Documents
DATE ISSUED 03 18 2014	CONTRACT FOR General Construction	CONTRACT DATED
ARCHITECT Boulder Associates, Inc. 1426 Pearl Street, Suite 300 Boulder, CO 80302	CONTRACTOR GH Phipps 5995 Greenwood Plaza Blvd. Suite 100 Greenwood Village, CO 80111	OWNER Eating Recovery Center 7351 E. Lowry Blvd Suite 200 Denver, CO 80230

Please submit an itemized proposal for changes in the Contract Sum and Contract Time for proposed modifications to the Contract Documents described herein. Submit proposal within 14 calendar days, or notify the Architect in writing of the date on which you anticipate submitting your proposal.

THIS IS **NOT** A CHANGE ORDER, CONSTRUCTION CHANGE DIRECTIVE OR A DIRECTION TO PROCEED WITH THE WORK DESCRIBED IN THE PROPOSED MODIFICATIONS.

DESCRIPTION

This PR documents the changes marked-up / revised per the casework, fireplace, and teaching kitchen hood, and kitchen submittals.


1. Added casework type "B26" to provide required food service legs as required by code in Dining 161. See 3/A6.2 and 17/A7.4
2. Added finished p-lam panel at East side counter in 161 and clarified dimensions. See 3/A6.2
3. Added casework type "B27" to clarify with the sliding casework doors shown in elevations 6 & 9/A6.2 and 18/A7.4
4. Revised East elevation of Teaching Kitchen (10/A6.2) to provide required side approach door clearance and revised location of the Ansul system box to fit in cabinet (21"W x 24"H x 8" D)
5. Changed sink casework type in rooms 185 and 292 to "S21" in lieu of "S03" See elevations 23/A6.2 and 12/A6.4
6. Changed depth of shelving to 24" deep in lieu of 18" at back wall of rooms 249, 252, and 254 per owner request. See A2.2B
7. Modified counters at coiling counter doors in Meds Rooms 275 and 276 to be 4" deep in lieu of 24" on room side. See 1, 3, & 5/A6.4 and
8. Revised fireplace type and elevation in room 292, per returned fireplace submittal. See 12/A6.4.
9. Revised height of island soffit in Teaching Kitchen 163 per comments in submittal to provide minimum bottom of hood dimension of 6'-8". See A9.1B.
10. Add switch for control of sneeze guard lights as shown on revised sheet E4.1.

ATTACHMENTS A2.1B, A2.2B, A6.2, A6.4, A7.4, A8.2, A9.1B, and E4.1

ISSUED BY
Mark Blaser

SIGNATURE

T:\Lib\111101 3/18/2014 5:30:05 PM C:\Users\mbaser\Documents\132258.00 A13 Covering.mtlblaser.rvt

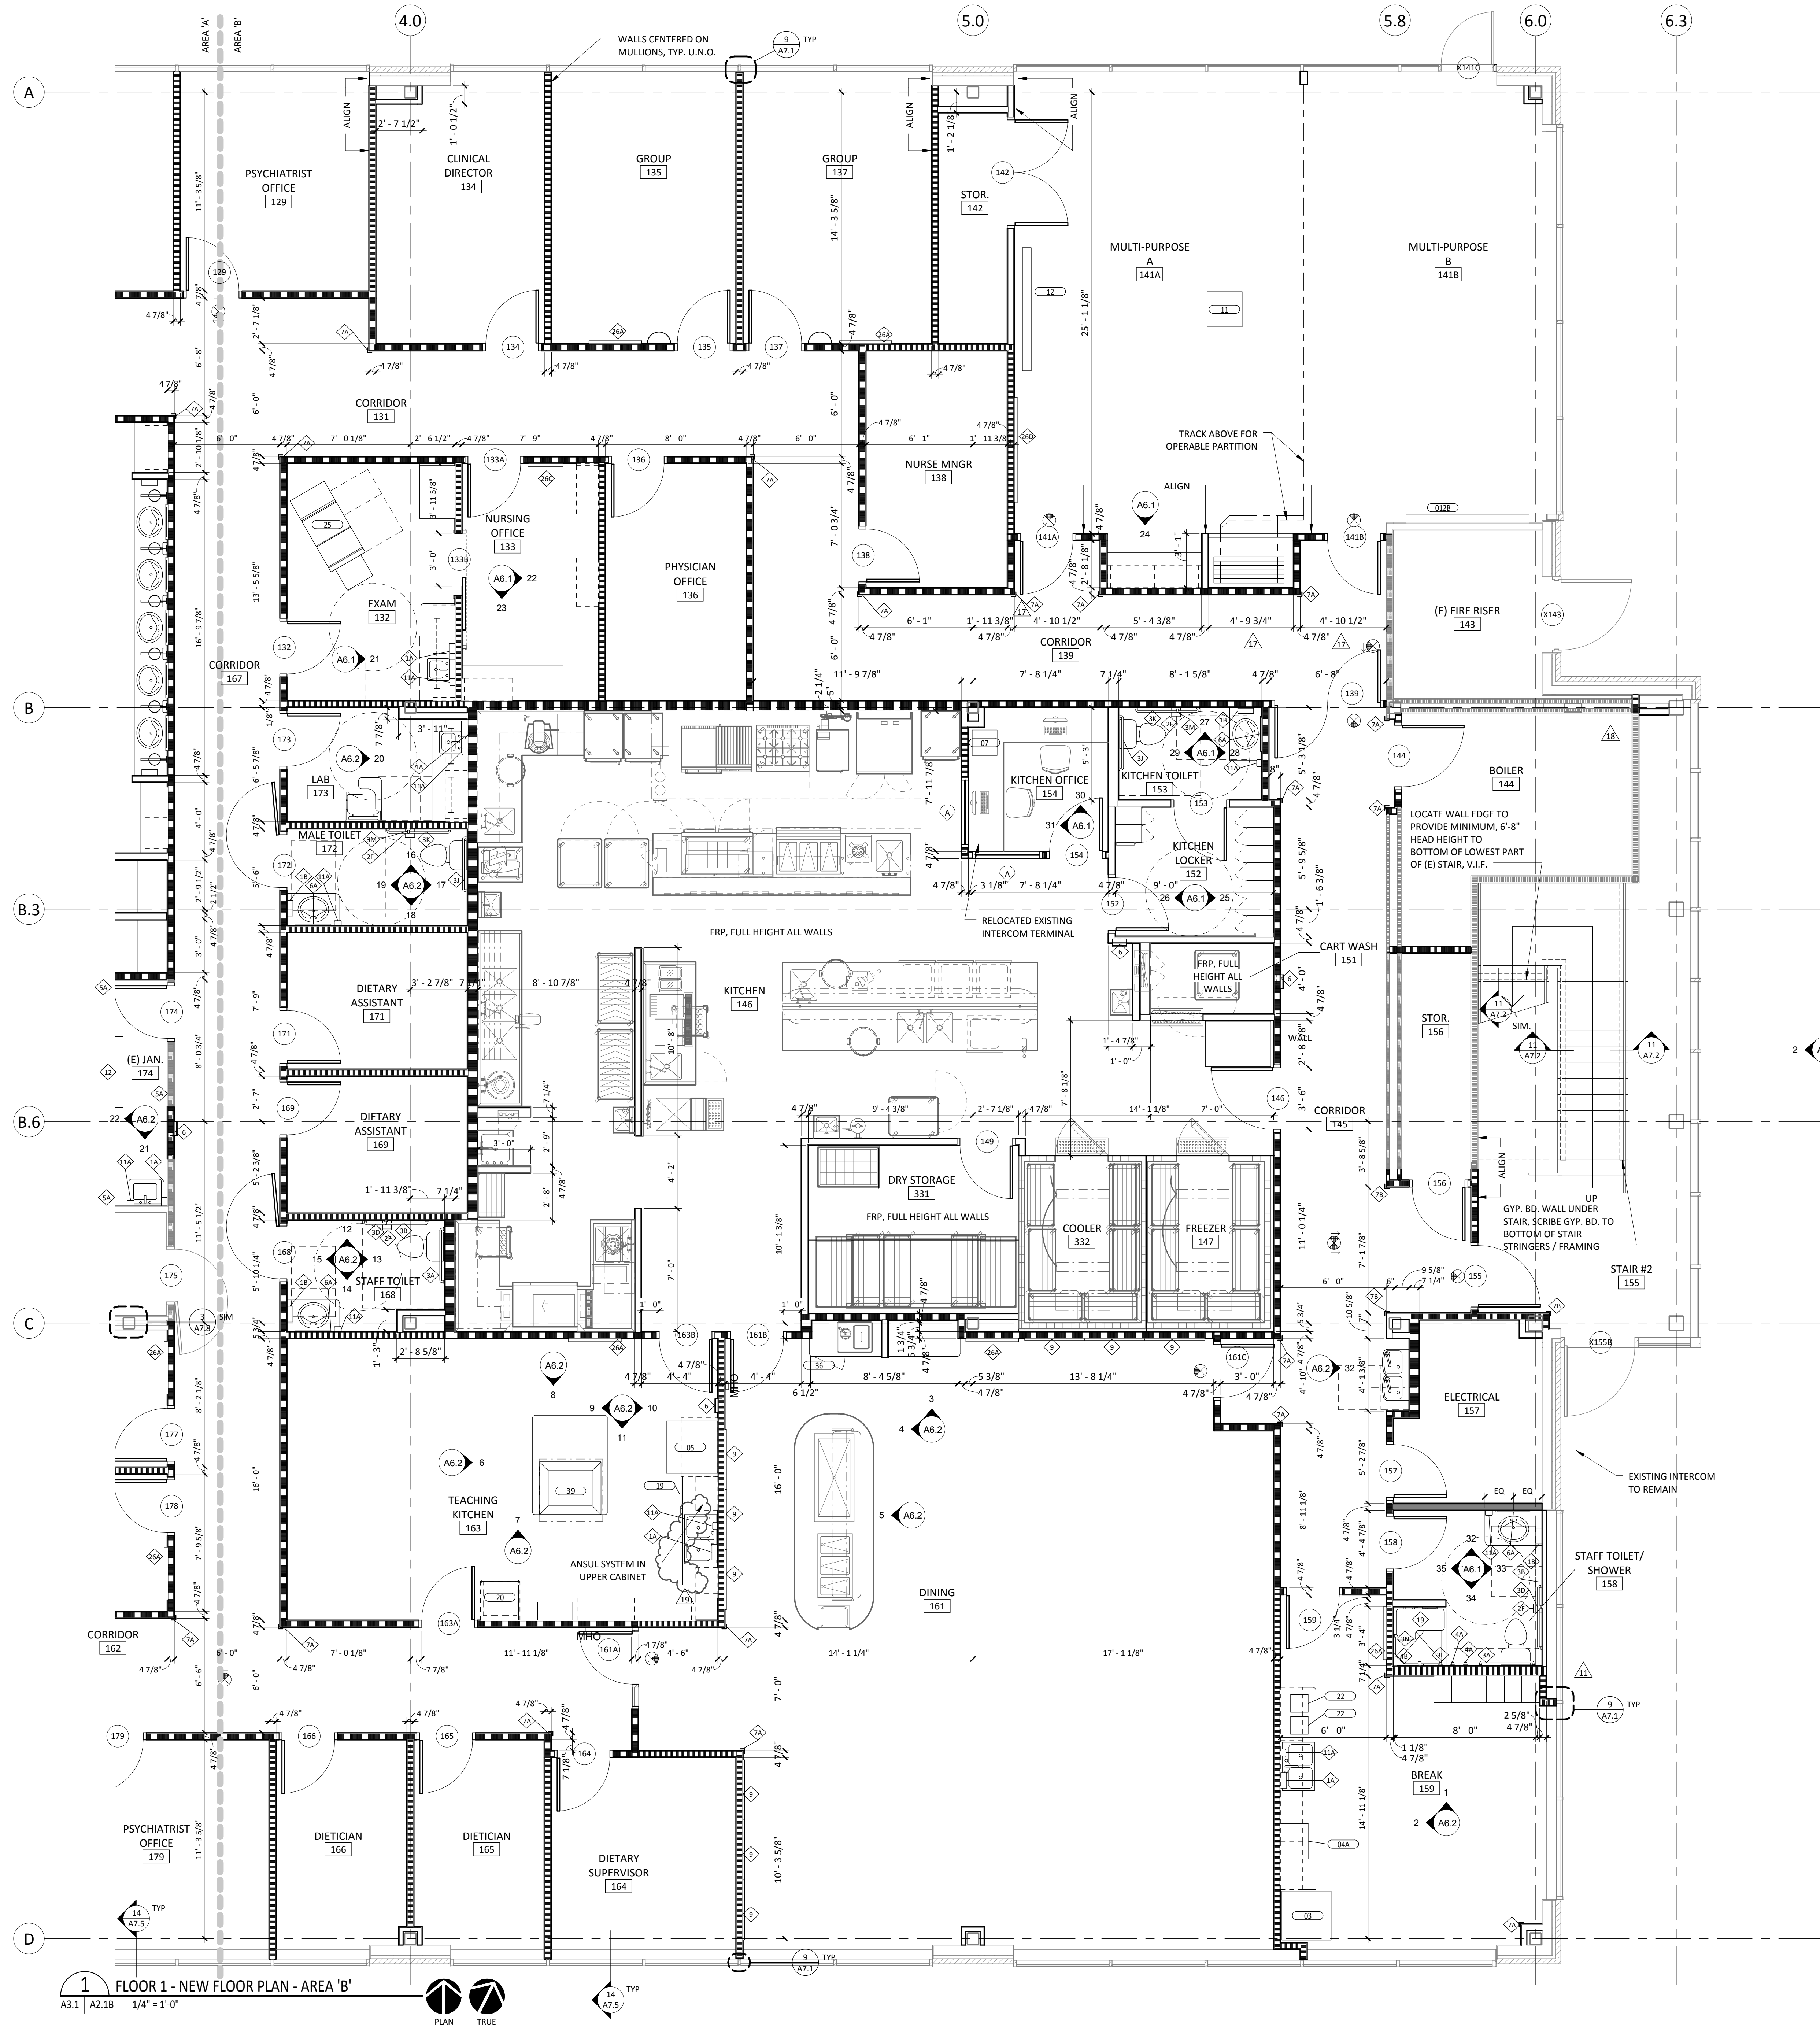

LEGEND - WALL TYPES

- EXISTING WALL
- EXISTING WALL, UPGRADED TO SMOKE PARTITION
- EXISTING WALL, UPGRADED TO SMOKE BARRIER
- EXISTING SHAFT WALL, UPGRADED TO 1 HR. RATED FIRE BARRIER
- EXISTING 1 HR. RATED FIRE BARRIER
- TYPICAL PARTITION, SEE DETAIL 1/A7.1
- SOUND PARTITION, SEE DETAIL 2/A7.1
- NON-RATED FULL HEIGHT PARTITION, SEE DETAIL 3/A7.1
- SMOKE PARTITION, SEE DETAIL 4/A7.1
- SMOKE BARRIER, SEE DETAIL 6/A7.1
- 1 HR. RATED FIRE BARRIER, SEE DETAIL 6/A7.1
- 1 HOUR RATED SHAFT WALL, SEE DETAIL 8/A7.1


GENERAL FLOOR PLAN NOTES

- DIMENSIONS ARE TO FACE OF FINISH WALL MATERIALS.
- ALL GYPSUM WALLBOARD TO BE 5/8" TYPE "X".
- UNLESS OTHERWISE NOTED, DOORS SHALL BE LOCATED 2" FROM ADJACENT PERPENDICULAR WALLS TO THE OUTSIDE EDGE OF THE DOOR FRAME.
- UNLESS OTHERWISE NOTED, ELECTRICAL, TELEPHONE AND COMMUNICATION OUTLETS ARE TO BE MOUNTED VERTICALLY WITH CENTERLINE AT 18" ABOVE THE FLOOR.
- PROVIDE 5/8" WATER RESISTANT GYPSUM BOARD AT ALL WET LOCATIONS INCLUDING ON WALLS BEHIND PLUMBING FIXTURES.
- PROVIDE LOCKS ON ALL CASEWORK DOORS AND DRAWERS UNLESS NOTED OTHERWISE. CONFIRM KEYING WITH OWNER PRIOR TO INSTALLATION.
- OUTLETS AND SWITCHES TO ALIGN WITH LIGHT FIXTURE, ACCESSORIES, & OUTLETS ABOVE. SEE INTERIOR ELEVATIONS FOR EXACT LOCATION.

SYMBOL LEGEND

SYMBOL	DESCRIPTION
	ACCESSORY TAG, SEE A6.4 FOR ACCESSORY SCHEDULE
	EQUIPMENT TAG, SEE A6.4 FOR EQUIPMENT SCHEDULE
	WINDOW TAG, SEE A8.2 FOR TYPES
	DOOR TAG, SEE A8.2 FOR SCHEDULE
	CARD READER
	MECHANICAL HOLD OPEN
	IPOD DOCKING STATION

KEYPLAN - AREA 'B'

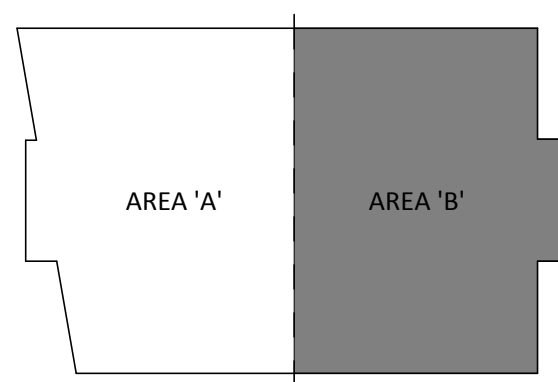

PROJECT NUMBER
132258.00

DRAWN BY
M. Blaser

DATE
NOVEMBER 26, 2013

REVISIONS

REV	DESCRIPTION	DATE
2	Addendum #2	12.10.13
11	PR #3	02.11.2014
17	ASI #03	02.21.2014
18	PR-08	03.13.2014
19	PR-09	3.18.2014

BOULDER ASSOCIATES

ARCHITECTS

Boulder Associates, Inc.
Architecture + Interior Design
1426 Pearl Street, Suite 300
Boulder, Colorado 80302
303.499.7795 F 303.499.7767
www.boulderassociates.com


PROJECT
ERC RESIDENTIAL PROGRAM & PHP

98 Spruce Street
Denver, CO 80230

SHEET TITLE
FLOOR 1 - FLOOR PLAN AREA 'B'

SHEET NUMBER

A2.1B


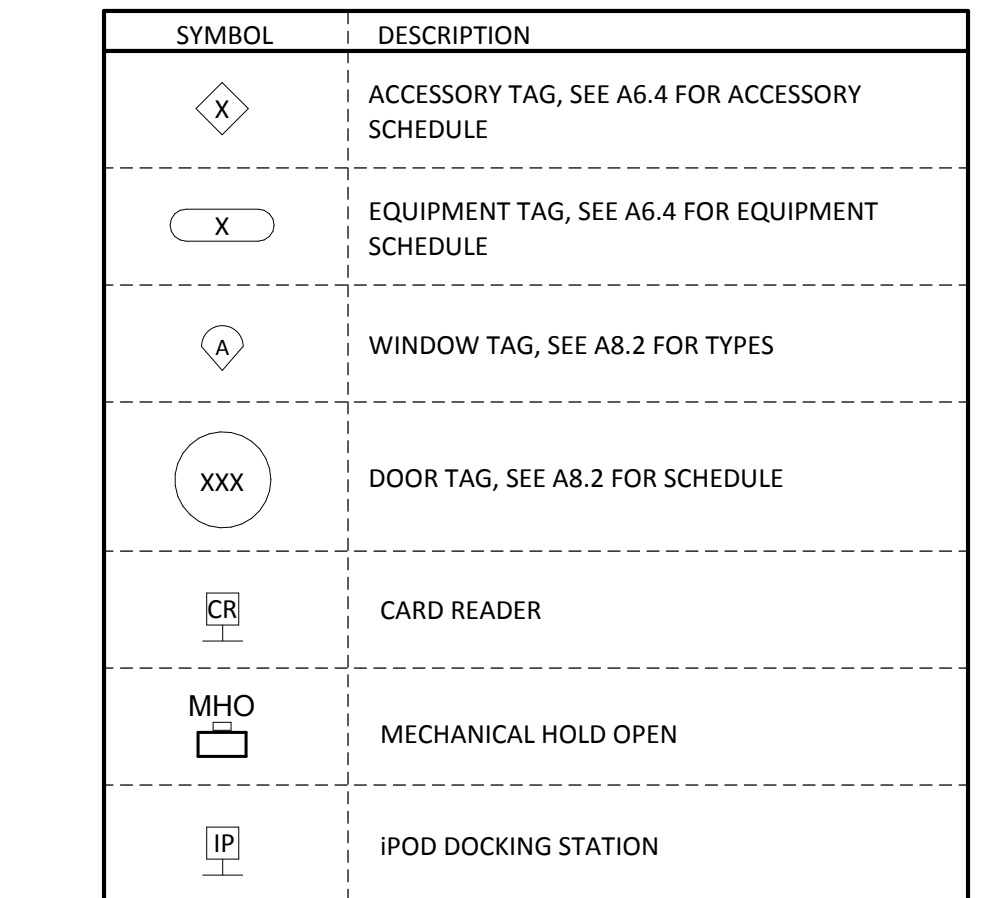


A2.2B




REVISIONS		
REV	DESCRIPTION	DATE
2	Addendum #2	12.10.13
9	PR #1	02.05.2014
11	PR #3	02.11.2014
18	PR-08	03.13.2014
19	PR-09	3.18.2014

INTERIOR ELEVATION NOTES

- ALL DIMENSIONS ON INTERIOR ELEVATIONS ARE TO FACE OF FINISH.
- DIMENSIONS OF DEVICES ARE TO CENTERLINE.
- FIELD VERIFY ALL DIMENSIONS.
- VERIFY ALL CLEARANCES REQUIRED FOR APPLIANCES.
- VERTICAL CASEWORK - WOOD GRAIN DIRECTION TO RUN VERTICALLY ON ALL VERTICAL SURFACES. SHOP DRAWINGS TO CALL OUT GRAIN DIRECTION FOR ARCHITECT TO VERIFY. ALL VERTICAL SURFACES SHALL BE PL1 U.N.O. ELEVATIONS.
- ALL COUNTERTOPS SHALL BE PL2 U.N.O. ON INTERIOR ELEVATIONS.
- ALL EXPOSED EDGES OF CASEWORK TO BE FINISHED.
- SEE SHEET A6.2 FOR ACCESSORY AND EQUIPMENT SCHEDULE.
- SEE 1/A7.3 FOR BACKING DETAIL. PROVIDE BACKING AS REQUIRED FOR ALL WALL MOUNTED ACCESSORIES AND EQUIPMENT.
- SEE 2/A7.3 FOR CONCEALED BRACE DETAIL; NOTED AS 'CB' ON INTERIOR ELEVATIONS.
- SEE 5/A7.3 FOR TYPICAL CASEWORK RADIUS, NOSE, AND SPLASH DETAIL.
- SEE 6/A7.1 FOR TYPICAL CASEWORK CORNER AND END DETAILS.
- SEE 7/A7.3 FOR GROMMET DETAIL. LOCATE PER OWNER IN FIELD.
- PROVIDE LOCKS ON ALL CASEWORK DOOR AND DRAWERS, UNLESS OTHERWISE NOTED.
- VERIFY KEYING WITH OWNER PRIOR TO INSTALLATION.
- BASE SHALL BE RB1 UNLESS NOTED OTHERWISE ON INTERIOR ELEVATIONS.

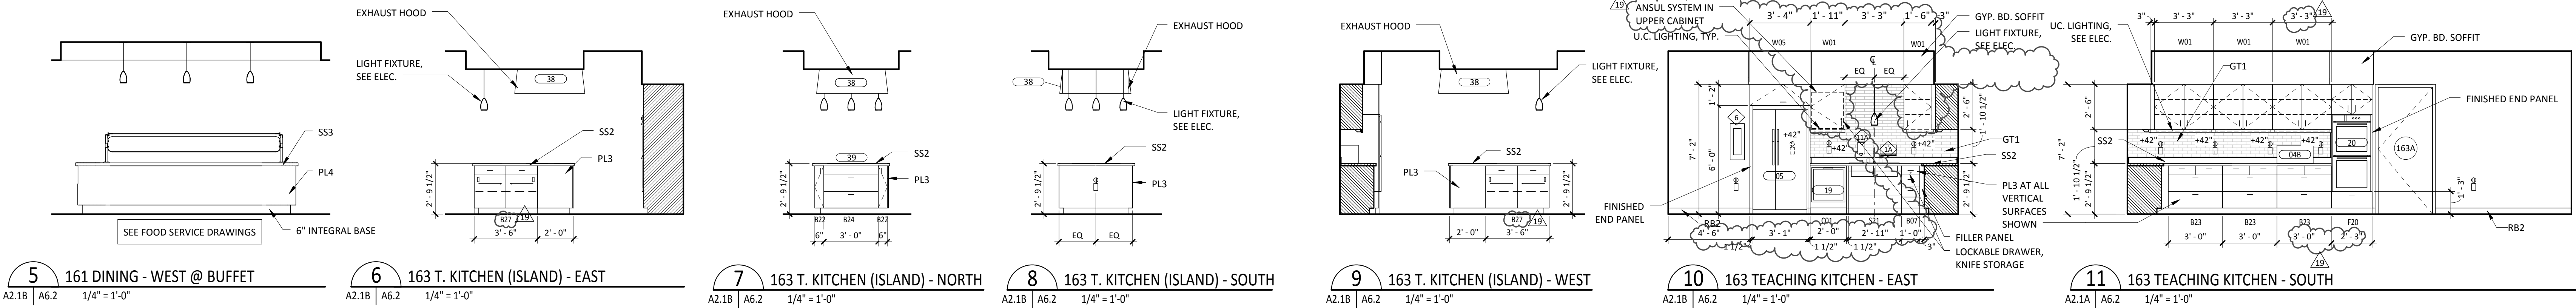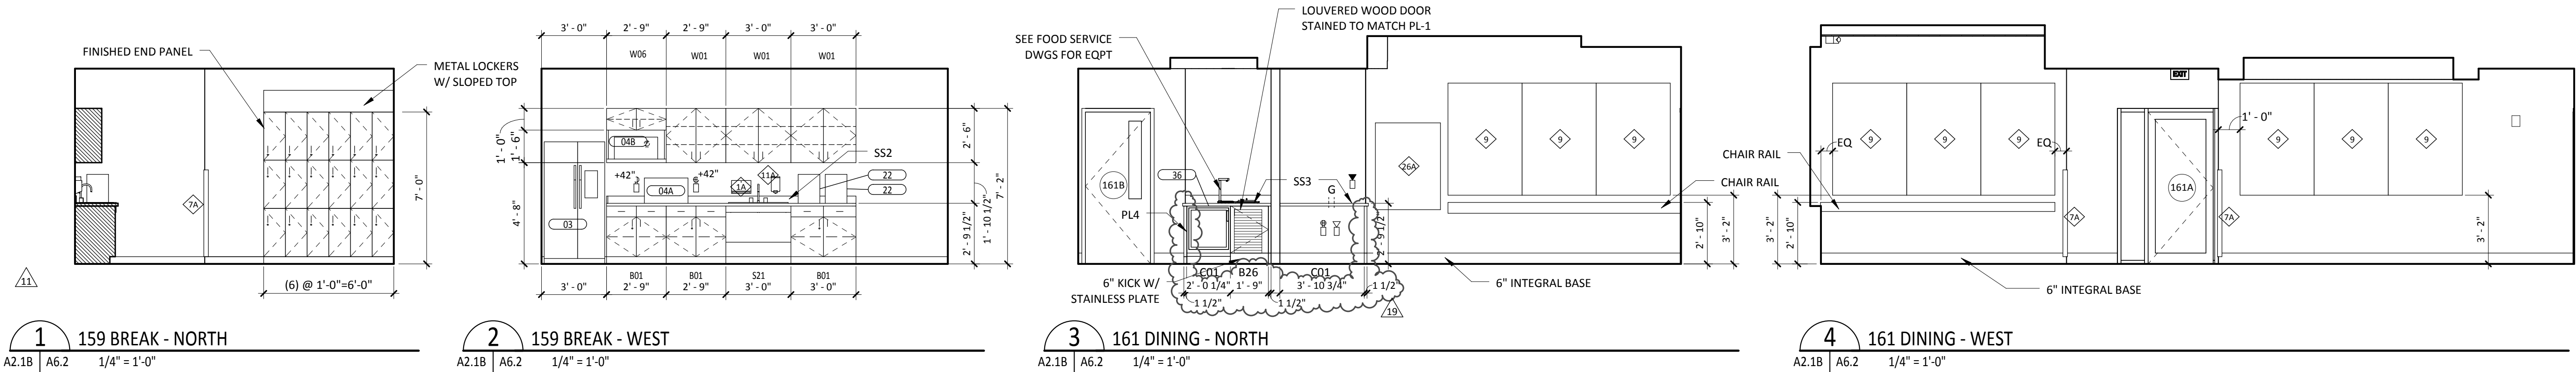

NO LOCKS AT CASEWORK IN TEACHING KITCHEN U.N.O.

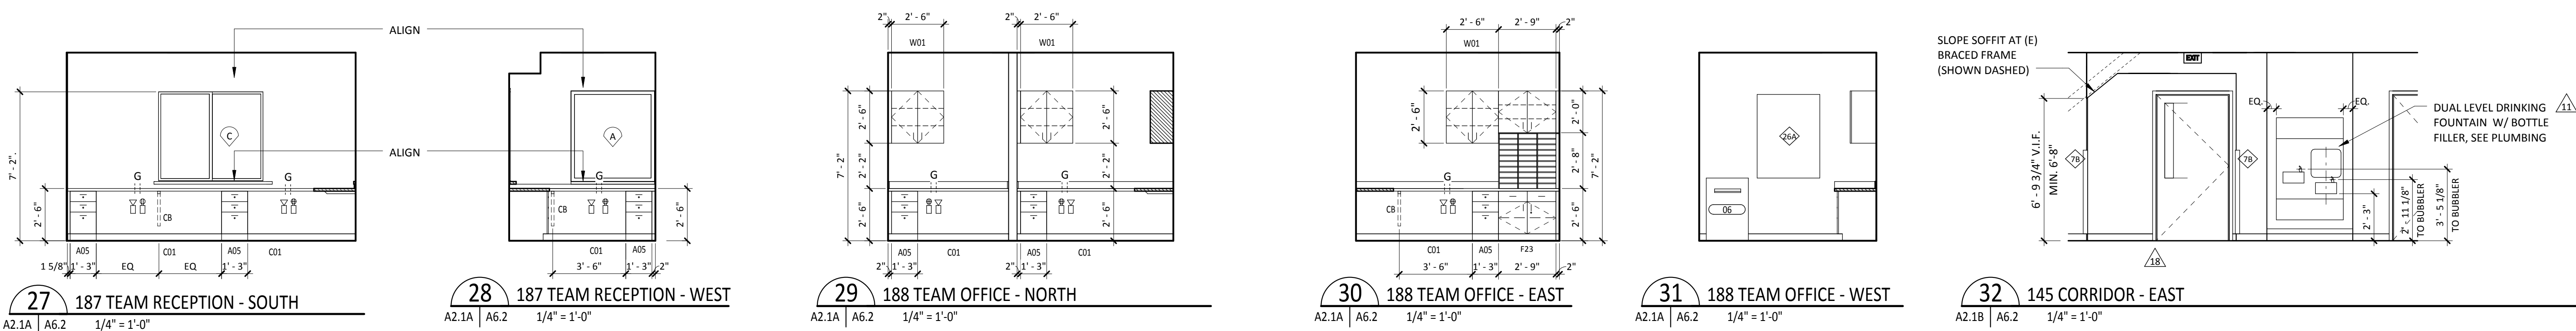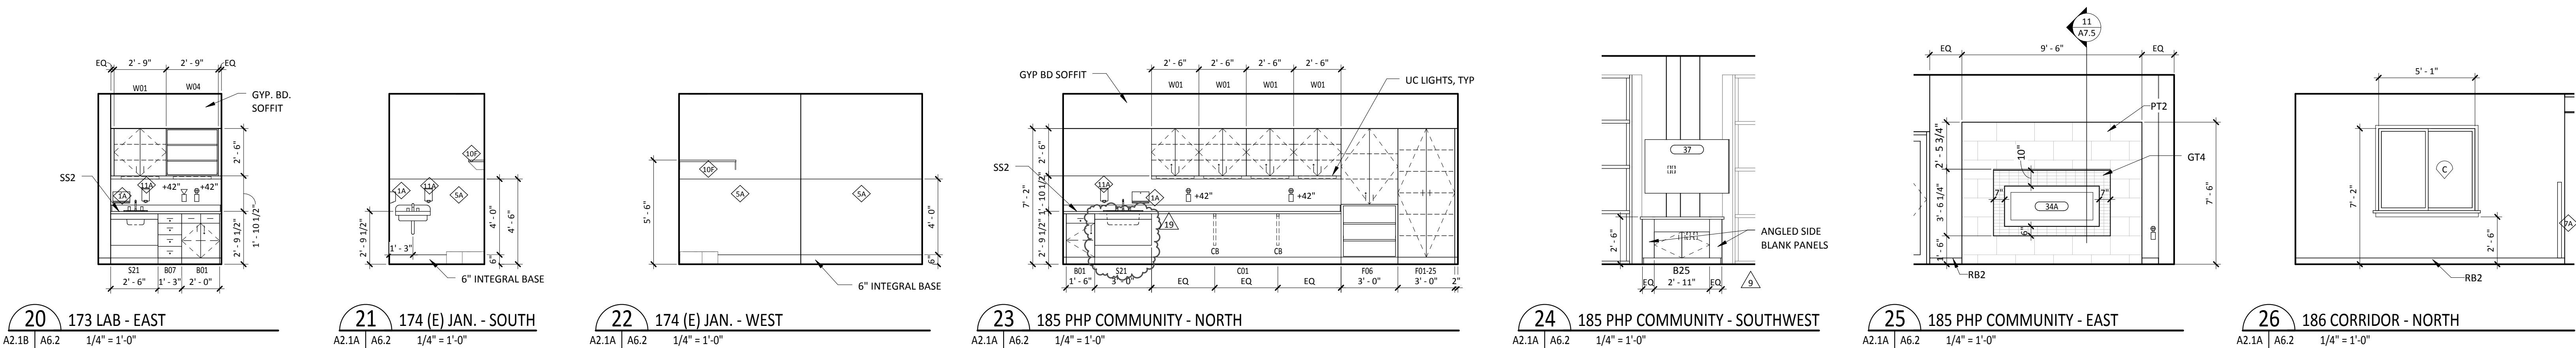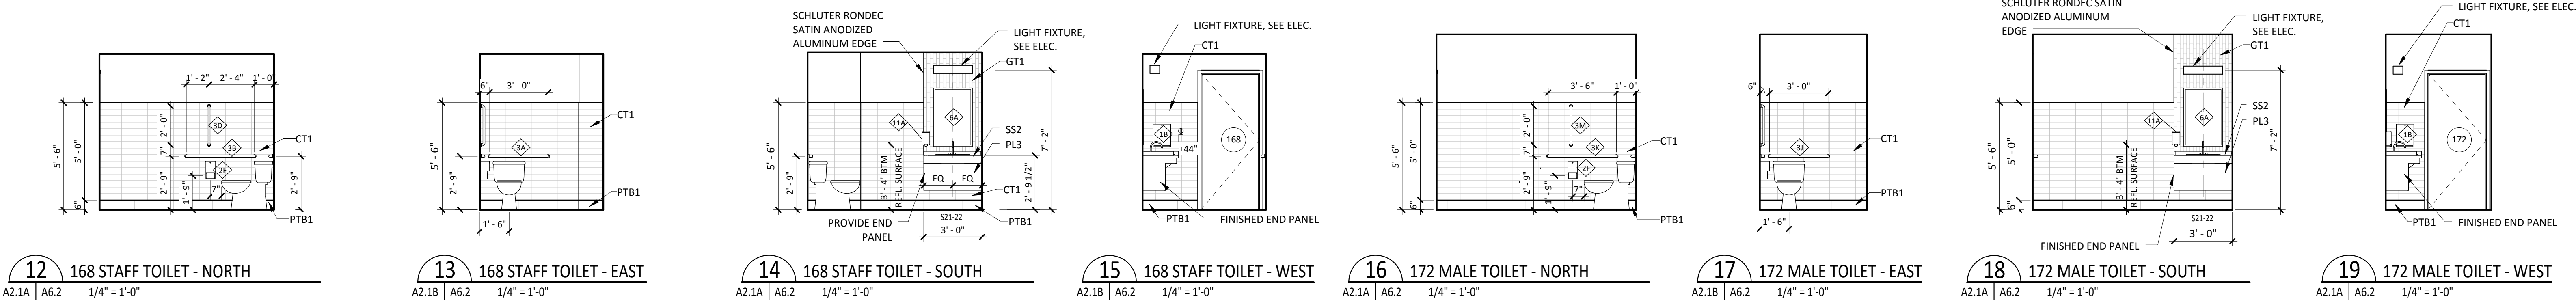

**BOULDER
ASSOCIATES**

ARCHITECTS

Boulder Associates, Inc.
Architecture + Interior Design
1426 Pearl Street, Suite 300
Boulder, Colorado 80302
303.499.7795 F 303.499.7767
www.boulderassociates.com

PROJECT
**ERC
RESIDENTIAL
PROGRAM & PHP**

98 Spruce Street
Denver, CO 80230

SHEET TITLE
**INTERIOR
ELEVATIONS**














SHEET NUMBER

A6.2

REVISIONS		
REV	DESCRIPTION	DATE
2	Addendum #2	12.10.13
9	PR #1	02.05.2014
19	PR-09	3.18.2014
20	ASI-04	3.18.2014

INTERIOR ELEVATION NOTES

- ALL DIMENSIONS ON INTERIOR ELEVATIONS ARE TO FACE OF FINISH.
- DIMENSIONS OF DEVICES ARE TO CENTERLINE.
- FIELD VERIFY ALL DIMENSIONS.
- VERIFY ALL CLEARANCES REQUIRED FOR APPLIANCES.
- VERTICAL CASEWORK - WOOD GRAIN DIRECTION TO RUN VERTICALLY ON ALL VERTICAL SURFACES. SHOP DRAWINGS TO CALL OUT GRAIN DIRECTION FOR ARCHITECT TO VERIFY. ALL VERTICAL SURFACES SHALL BE PL2 U.N.O. ELEVATIONS.
- ALL COUNTERTOPS SHALL BE PL2 U.N.O. ON INTERIOR ELEVATIONS.
- ALL EXPOSED EDGES OF CASEWORK TO BE FINISHED.
- SEE SHEET A6.2 FOR ACCESSORY AND EQUIPMENT SCHEDULE.
- SEE 3/A7.3 FOR BACKING DETAIL. PROVIDE BACKING AS REQUIRED FOR ALL WALL MOUNTED ACCESSORIES AND EQUIPMENT.
- SEE 2/A7.3 FOR CONCEALED BRACE DETAIL, NOTED AS 'CB' ON INTERIOR ELEVATIONS.
- SEE 5/A7.3 FOR TYPICAL CASEWORK RADIUS, NOSE, AND SPLASH DETAIL.
- SEE 6/A7.1 FOR TYPICAL CASEWORK CORNER AND END DETAILS.
- SEE 7/A7.3 FOR GROMMET DETAIL. LOCATE PER OWNER IN FIELD.
- PROVIDE LOCKS ON ALL CASEWORK DOOR AND DRAWERS, UNLESS OTHERWISE NOTED.
- VERIFY KEYING WITH OWNER PRIOR TO INSTALLATION.
- BASE SHALL BE RB1 UNLESS NOTED OTHERWISE ON INTERIOR ELEVATIONS.

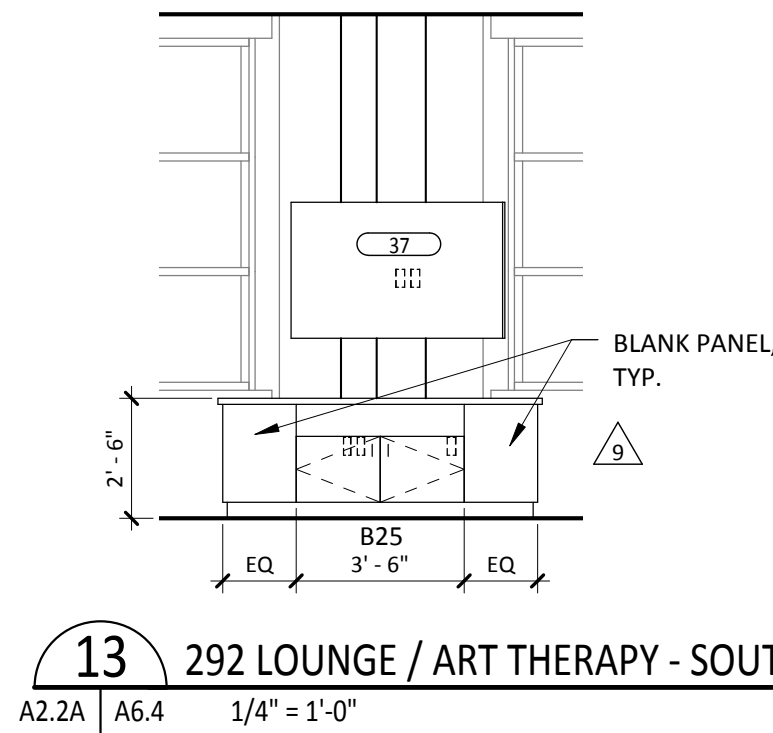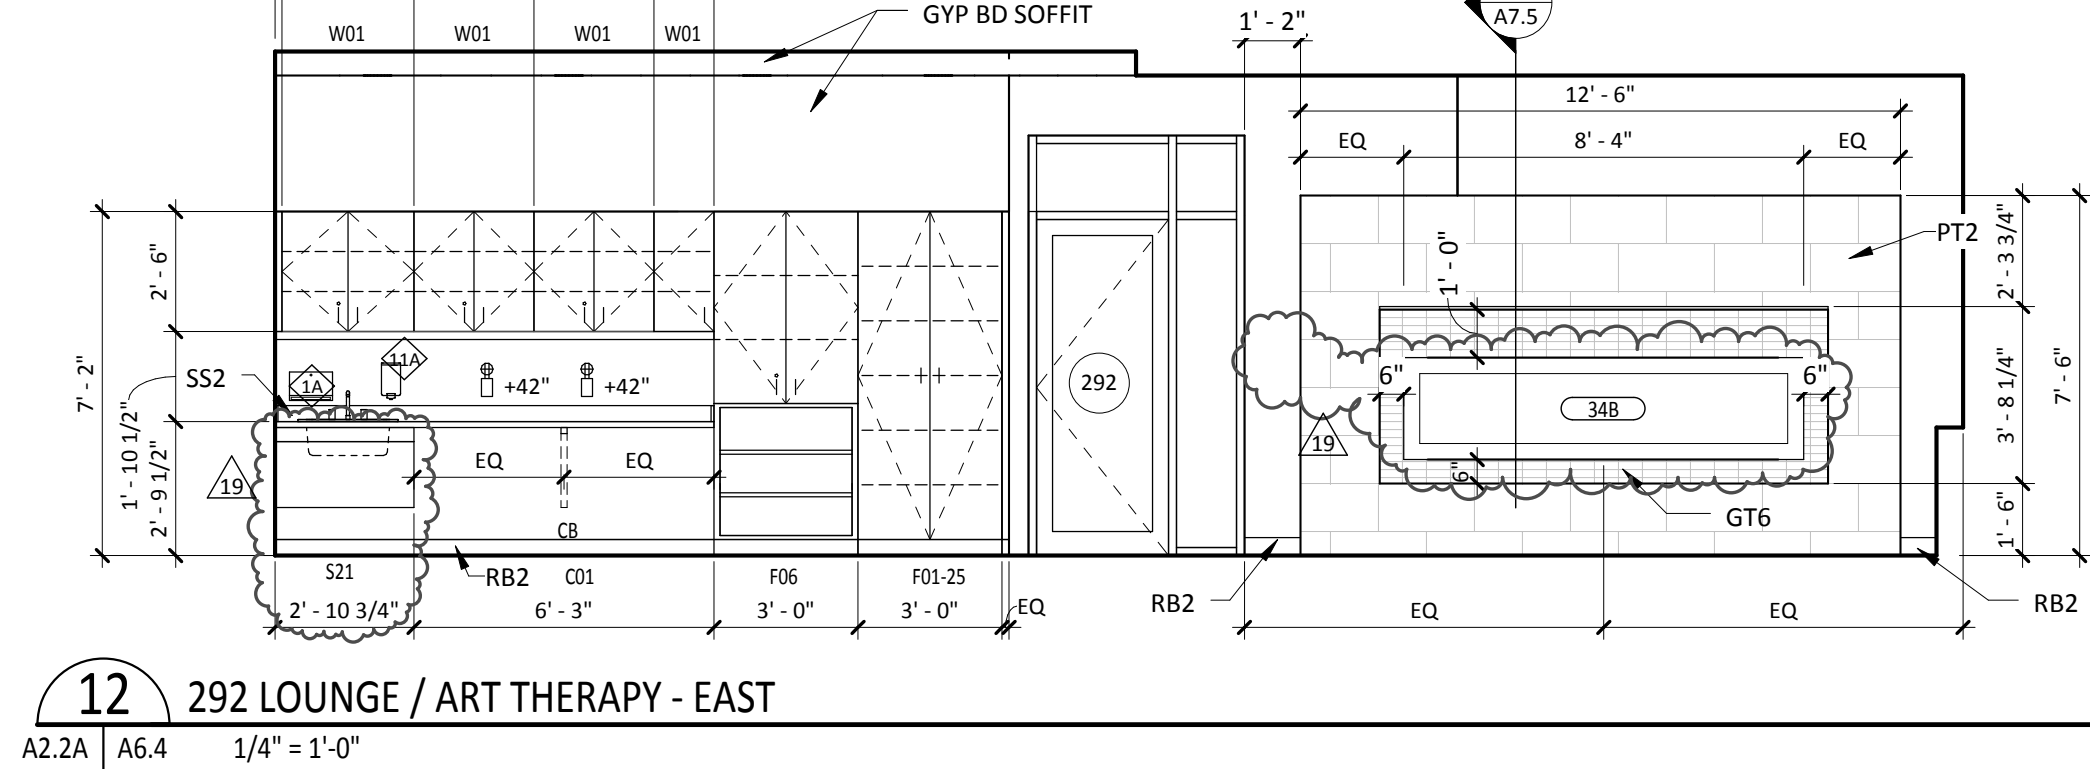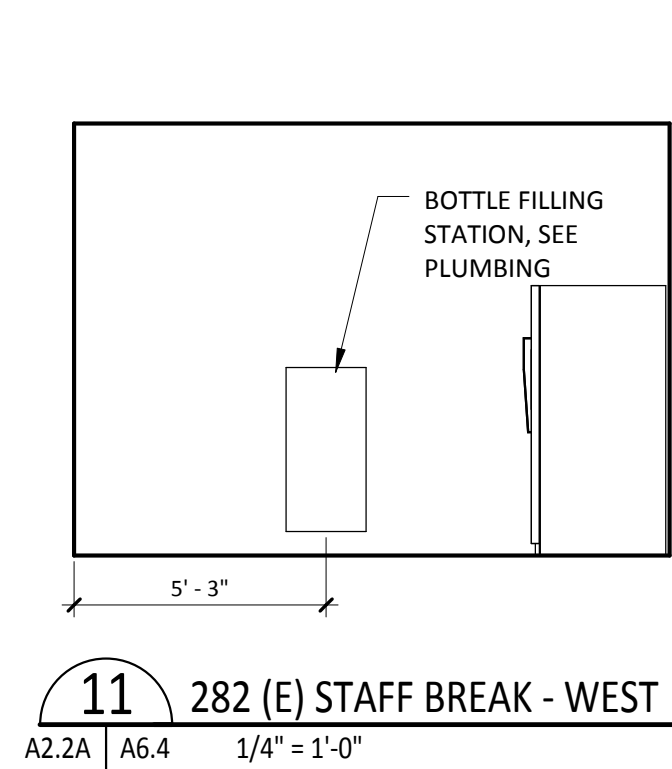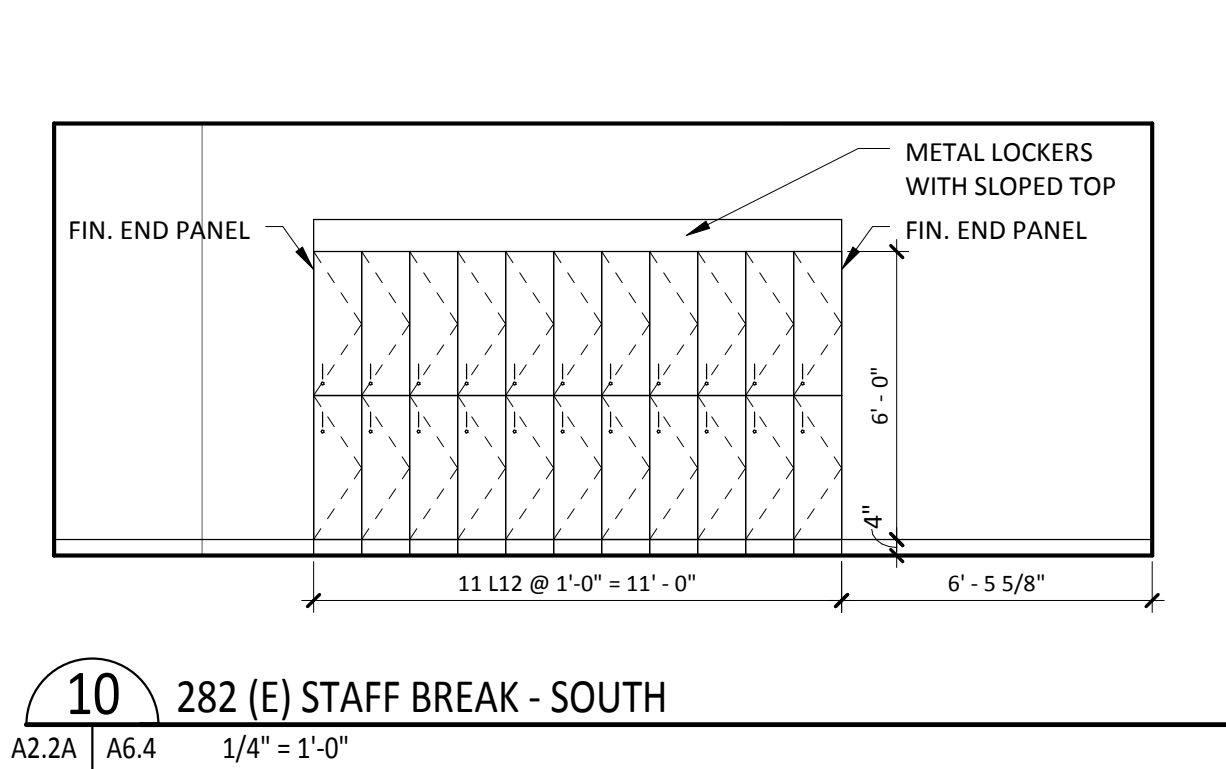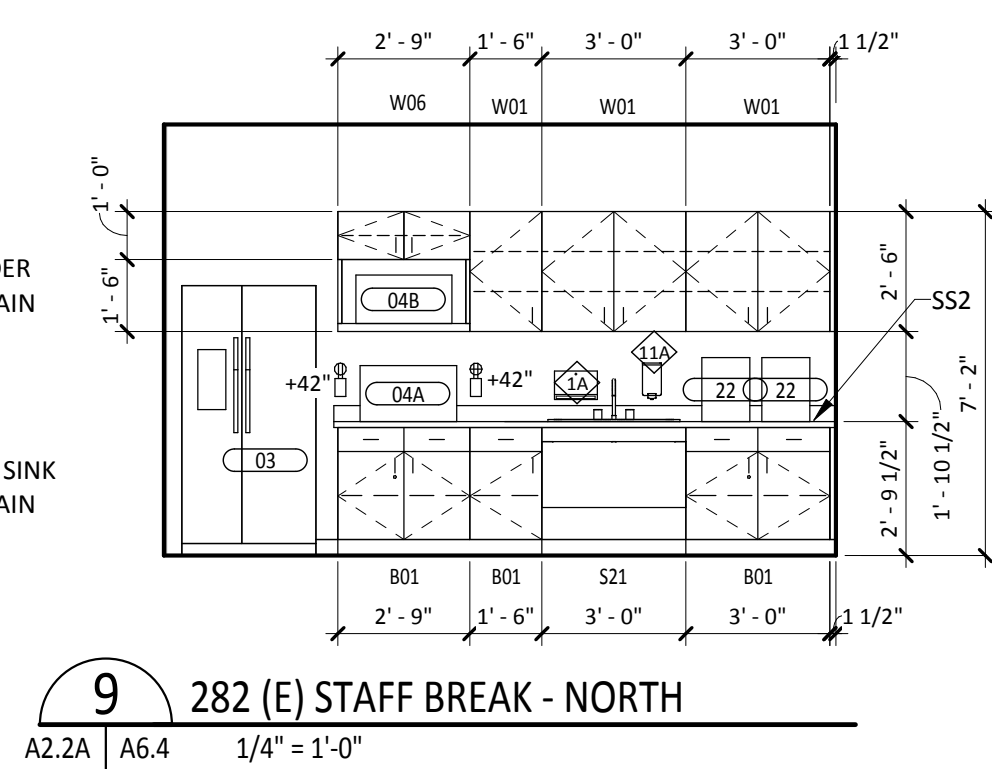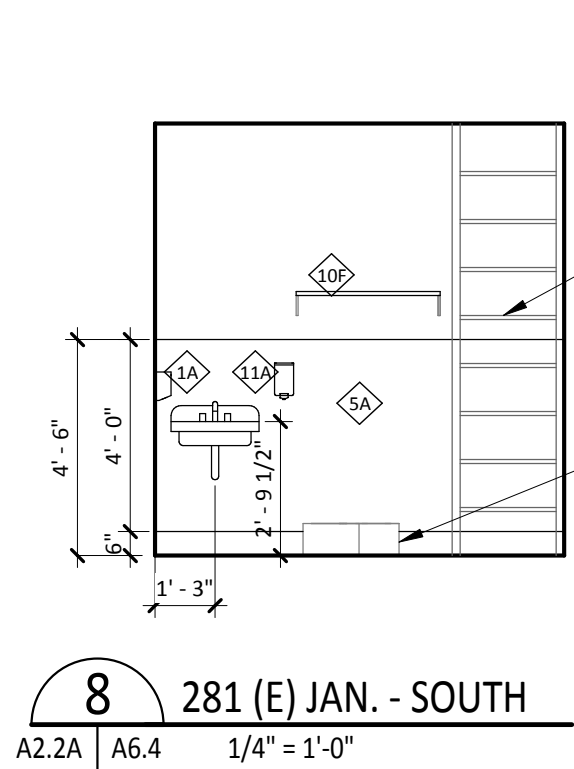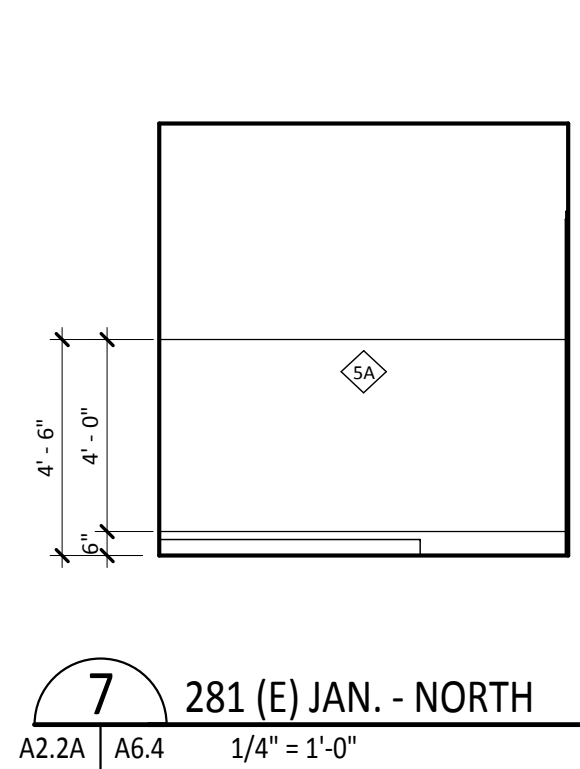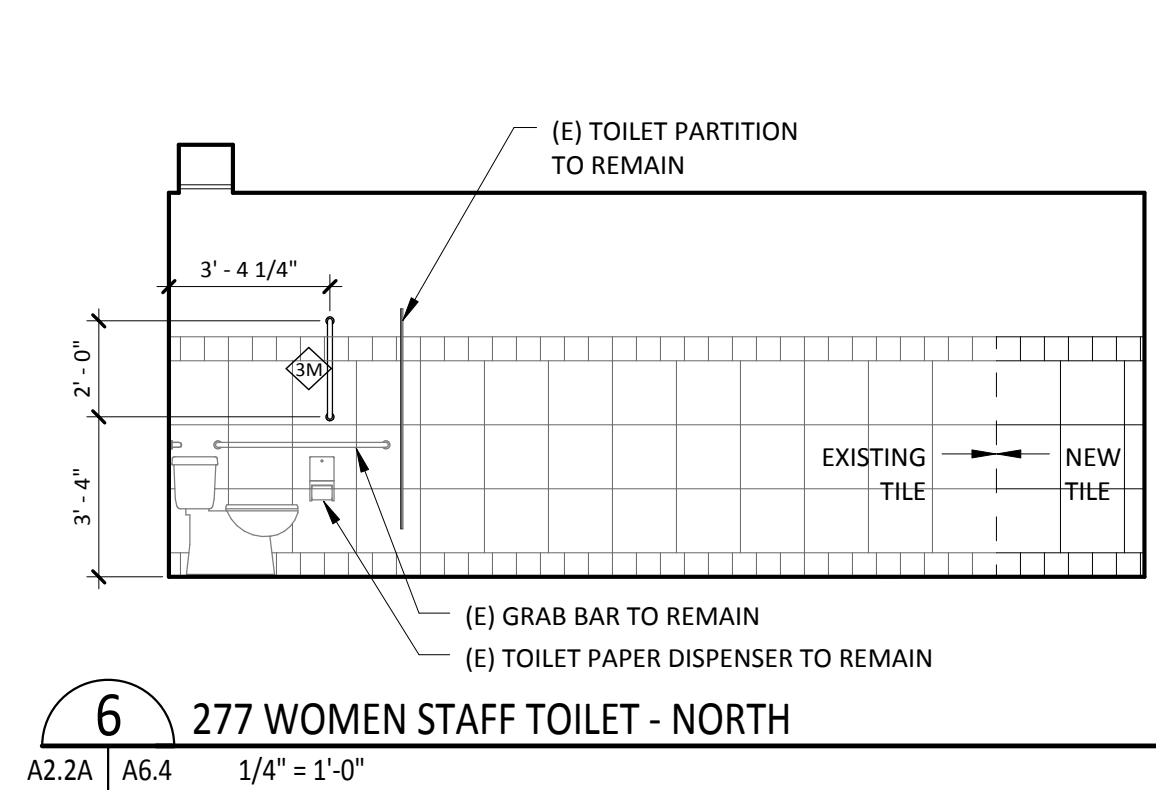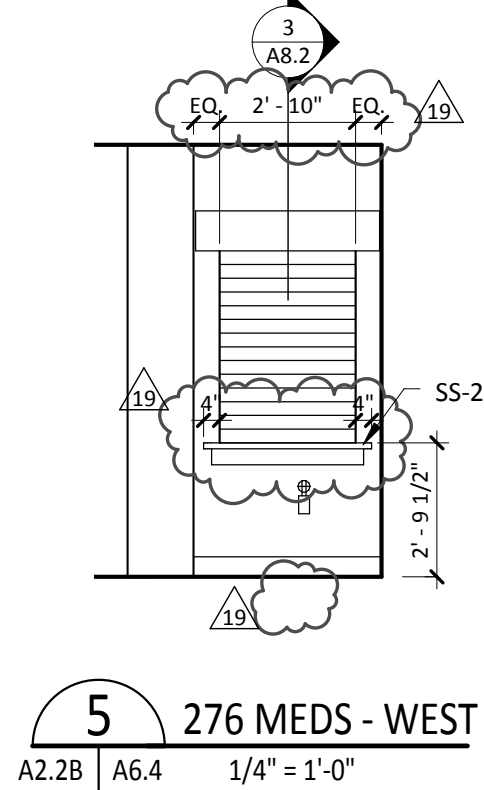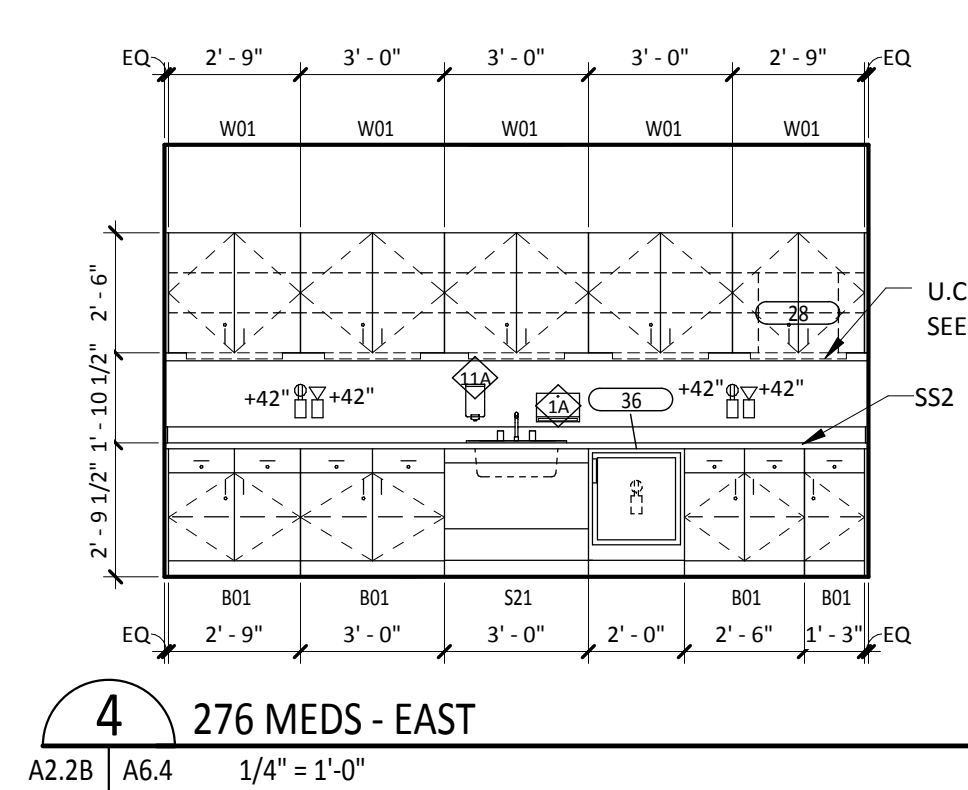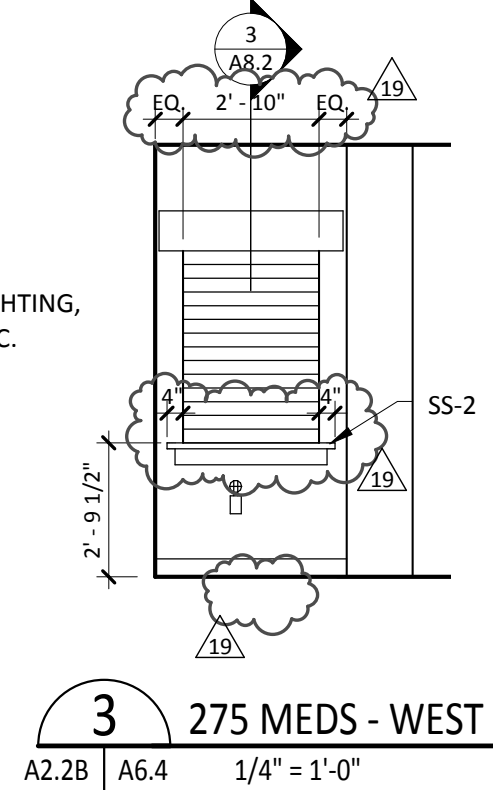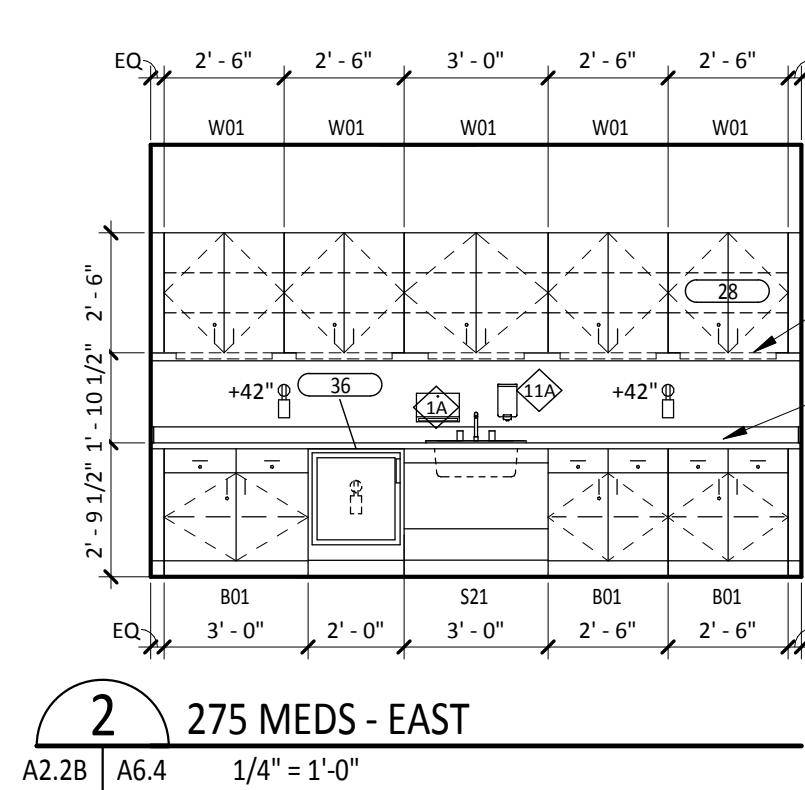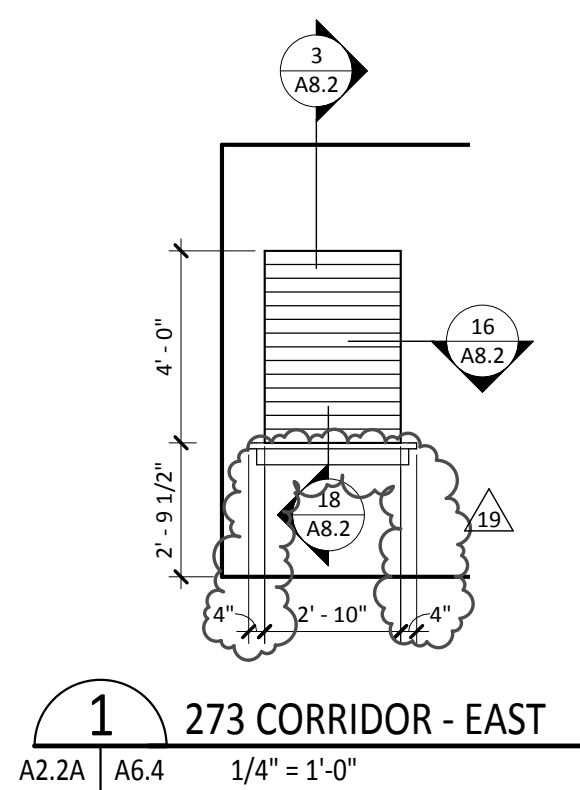

ACCESSORY SCHEDULE					
TYPE	DESCRIPTION	MFR.	MODEL	RESPONSIBILITY	COMMENTS
1A	PARTIAL HEIGHT PAPER TOWEL DISPENSER	BOBRICK	B-2621	CF/CI	BOTTOM @ 39" A.F.F.
1B	FULL HEIGHT PAPER TOWEL DISPENSER	BOBRICK	B-2620	CF/CI	BOTTOM @ 39" A.F.F.
2F	TOILET PAPER DISPENSER	BOBRICK	B-4208	CF/CI	
3A	36" S.S. GRAB BAR	BOBRICK	B-6806 x 36	CF/CI	SEE 3/A7.3 FOR GRAB BAR MOUNTING INFORMATION
3B	42" S.S. GRAB BAR	BOBRICK	B-6806 x 42	CF/CI	SEE 3/A7.3 FOR GRAB BAR MOUNTING INFORMATION
3D	24" S.S. VERTICAL GRAB BAR	BOBRICK	B-6806 x 24	CF/CI	SEE 3/A7.3 FOR GRAB BAR MOUNTING INFORMATION
3H	SHOWER L-SHAPED S.S. SECURITY GRAB BAR	A&J WASHROOM	US130-G3016R	CF/CI	SEE 3/A7.3 FOR GRAB BAR MOUNTING INFORMATION
3J	36" S.S. SECURITY GRAB BAR	BRADLEY	SA70-001360	CF/CI	SEE 3/A7.3 FOR GRAB BAR MOUNTING INFORMATION
3K	42" S.S. SECURITY GRAB BAR	BRADLEY	SA70-001420	CF/CI	SEE 3/A7.3 FOR GRAB BAR MOUNTING INFORMATION
3L	18" S.S. SECURITY GRAB BAR - VERTICAL	BRADLEY	SA70-00180	CF/CI	SEE 3/A7.3 FOR GRAB BAR MOUNTING INFORMATION
3M	24" S.S. SECURITY GRAB BAR - VERTICAL	BRADLEY	SA70-001240	CF/CI	SEE 3/A7.3 FOR GRAB BAR MOUNTING INFORMATION
3N	SHOWER L-SHAPED S.S. GRAB BAR	A&J WASHROOM	US130-G3016	CF / CI	SEE 3/A7.3 FOR GRAB BAR MOUNTING INFORMATION
4A	SINGLE ROBE HOOK	BOBRICK	B-983	CF/CI	
4B	SOLID SURFACE CORNER SHELF	CUSTOM		CF/CI	SEE DETAIL 8/A7.5
5A	WALL PROTECTION SHEET - 48" HIGH	C/S ACROVYN	PVC-FREE 4,000 SERIES	CF/CI	FOR COLOR: REFER TO MATERIALS LIST ID1.1 (WP1). INSTALL @ 48" ABOVE BASE.
6	SEMI-RECESSED FIRE EXTINGUISHER CABINET	LARSENS	2409-R3	CF / CI	W/ MP-5 EXTINGUISHER
6A	CHANNEL-FRAMED MIRROR, 24" x 36"	BOBRICK	B165-2436	CF/CI	LAMINATED GLASS, BOTTOM OF REFLECTIVE SURFACE @ 3'-4"
6C	ALUMINUM FRAMED MIRROR, 24" x 36"	CR LAURENCE	RF144BN (FRAME), DMF144H (HARDWARE PACK)	CF/CI	LAMINATED GLASS, BOTTOM OF REFLECTIVE SURFACE @ 3'-4", SEE DETAIL10/A7.5
7A	2" CORNER GUARD	C/S ACROVYN	SSM20	CF/CI	INSTALL 48" ABOVE BASE, COLOR: FRENCH CREAM #101
7B	2" STAINLESS STEEL CORNER GUARD	SEE SPECS	SEE SPECS	CF / CI	INSTALL 48" ABOVE BASE
8	SPECIMEN PASS-THROUGH	BOBRICK	B-505	CF / CI	
9	ACOUSTICAL WALL PANEL	NOVAVALL	3'-5" W X 5'-2" H, 1" THICKNESS 6.0 PCF DENSE KNAUF ACOUSTICAL PANEL, SQUARE EDGE, FABRIC: KNOLL, PATTERN: ALLEGORY COLOR: COPPER, FABRIC TO BE UNBACKED.	CF / CI	SEE A6.1 AND A6.2 FOR MOUNTING INFORMATION
10F	MOP RACK W/ SHELF	BOBRICK	B224-36	CF/CI	
11A	SOAP DISPENSER	BOBRICK	B-2111	CF/CI	BOTTOM @ 39" A.F.F.
11B	SOAP DISPENSER	BOBRICK	B-4112	CF/CI	BOTTOM @ 39" A.F.F.
12	HOUSEKEEPING CART	-	-	OF/OI	
012B					
19	FOLDING SHOWER SEAT	BOBRICK	B-5181	CF/CI	
20A	SHARPS CONTAINER	-	-	OF/CI	
26A	MARKER BOARD	-	36" w x 48" h	OF/OI	
26B	MARKER BOARD	-	48" w x 48" h	OF/OI	
26C	MARKER BOARD	-	24" w x 48" h	OF/OI	
26D	MARKER BOARD	-	72" w x 48" h	OF/OI	
26E	MARKER BOARD W/ TACK SURFACE	-	36" w x 48" h	OF/OI	
30A	CUBICLE CURTAIN TRACK	SEE SPECS	SEE SPECS	CF/CI	SEE ID SHEETS FOR CURTAIN FABRIC INFORMATION

EQUIPMENT SCHEDULE				
TAG	DESCRIPTION	RESPONSIBILITY	MANUFACTURER	COMMENTS
01	WASHER	CF/CI	GE	GFWS1500DWW
02	DRYER	CF/CI	GE	GFDS1500DWW
03	REFRIGERATOR	CF/CI	GE	CSH215DSS
04A	MICROWAVE	OF/OI	GE	PEB7226SPSS
04B	MICROWAVE	OF/OI	GE	PEM315FSS
05	REFRIGERATOR	CF / CI	GE	PSH56MG2SS
06	FULL SIZE COPIER/PRINTER	OF/OI	-	-
07	DESKTOP COPY /PRINTER / FAX	OF/OI	-	-
11	CEILING MOUNTED PROJECTOR	OF/OI	-	-
12	PROJECTOR SCREEN	CF/CI	SEE SPEC	SEE SPEC
13	COMPUTER, WALL MOUNTED	OF/CI	-	-
19	DISHWASHER	CF/CI	GE	GLDA696FSS
20	DOUBLE OVEN	CF/CI	GE	JT55SPSS
22	COFFEE MAKER	OF/OI	-	-
24	SCALE	OF/OI	-	-
25	EXAM TABLE	OF/OI	-	-
28	LOCKING NARCOTICS CABINET	OF/OI	-	-
34A	ELECTRIC FIREPLACE	CF/CI	MODERN FLAMES	AMBIANCE AL60CLX
34B	ELECTRIC FIREPLACE	CF/CI	MODERN FLAMES	AMBIANCE AL100CLX
35	PHLEBOTOMY CHAIR	OF/OI	-	-
36	UNDERCOUNTER REFRIGERATOR	OF/OI	TBD	TBD
37	WALL MOUNTED TV W/ BRACKET	OF/CI	-	-
38	EXHAUST HOOD	CF / CI	WOLF (SUB-ZERO)	PI423418
39	COOKTOP	CF/CI	GE	JP356MSS

BOULDER
ASSOCIATES

ARCHITECTS

Boulder Associates, Inc.
Architecture + Interior Design
1426 Pearl Street, Suite 300
Boulder, Colorado 80302
303.499.7795 F 303.499.7767
www.boulderassociates.com

PROJECT
ERC
RESIDENTIAL
PROGRAM & PHP

98 Spruce Street
Denver, CO 80230

SHEET TITLE
INTERIOR
ELEVATIONS

SHEET NUMBER


A6.4

PROJECT NUMBER
132258.00


DRAWN BY
Author

DATE
NOVEMBER 26, 2013


REVISIONS		
REV	DESCRIPTION	DATE
2	Addendum #2	12.10.13
19	PR-09	3.18.2014

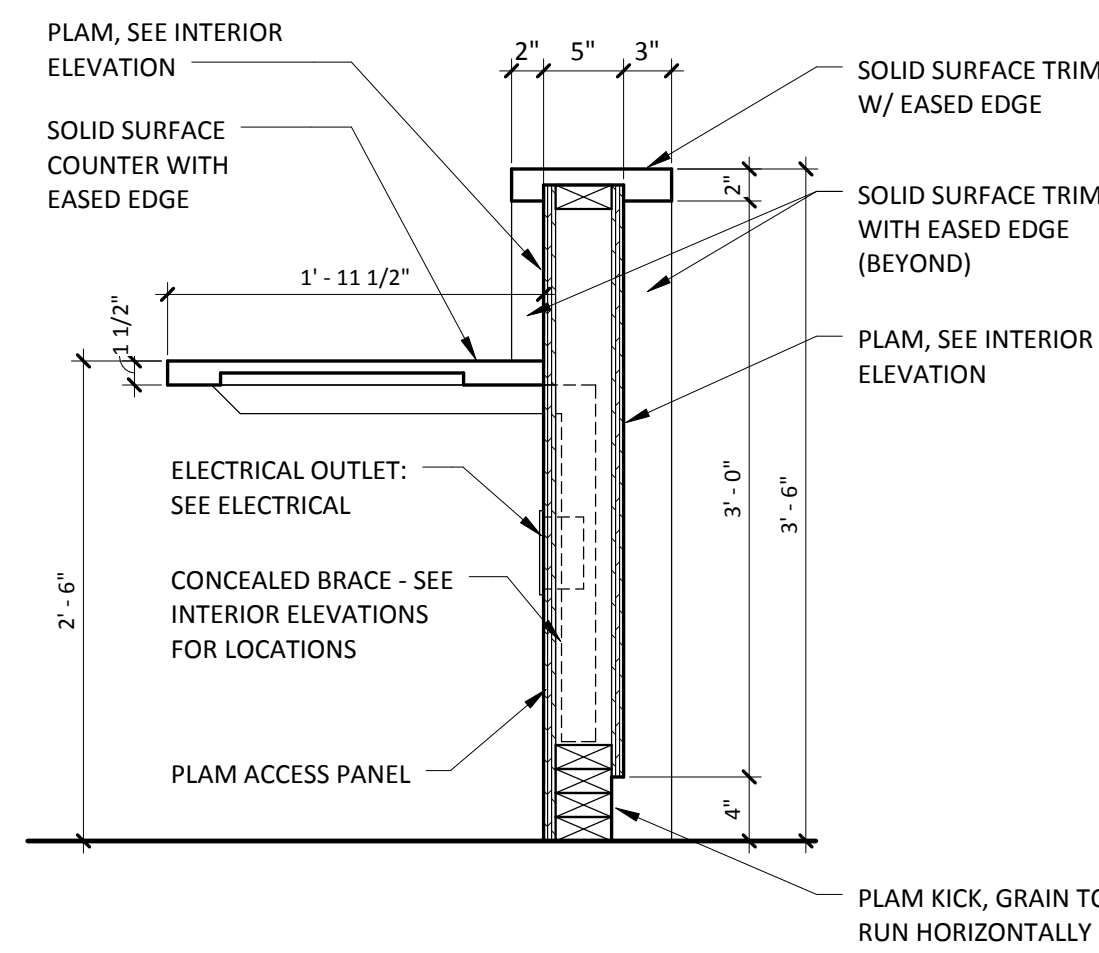


1 CASEWORK TYPE "R01"
A7.4 1" = 1'-0"

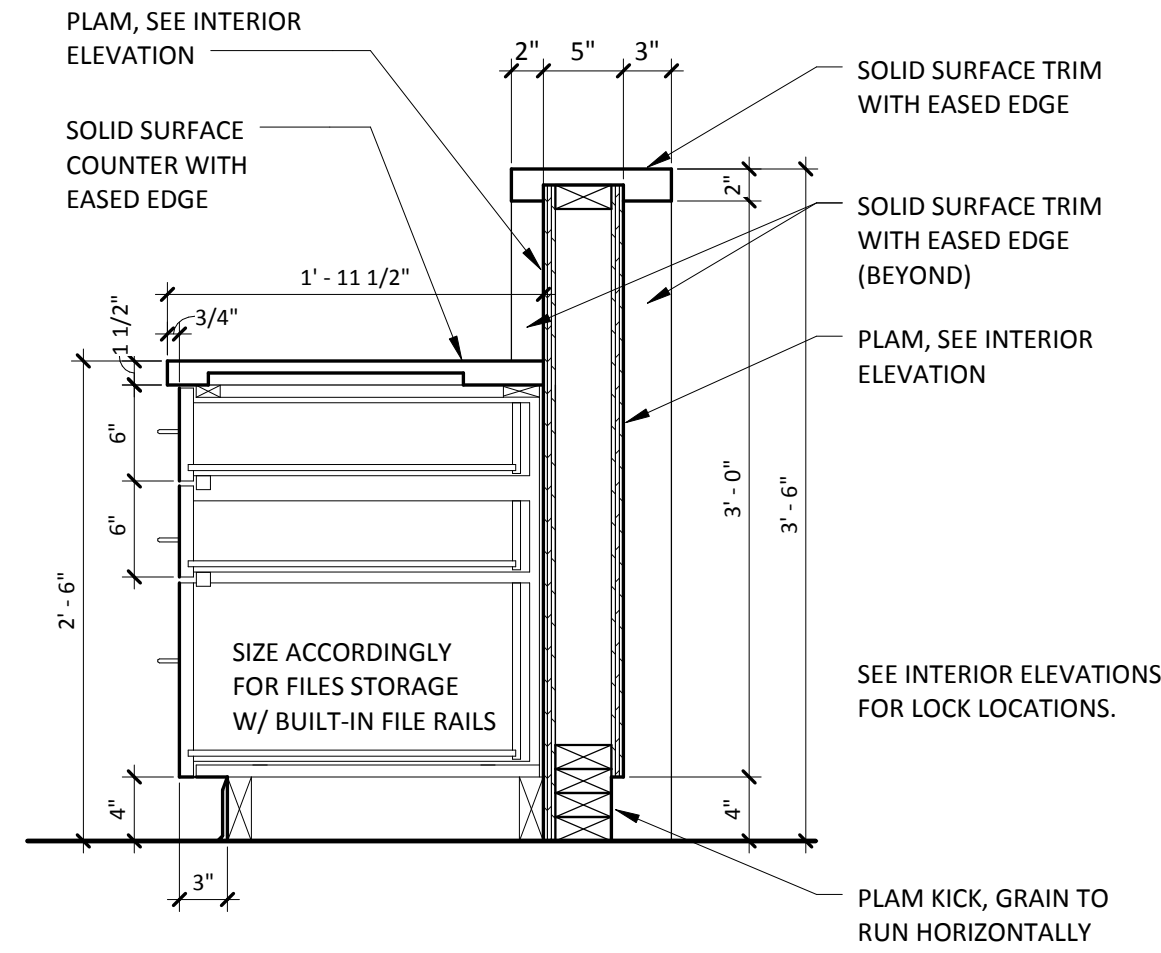


2 CASEWORK TYPE "R02"
A7.4 1" = 1'-0"

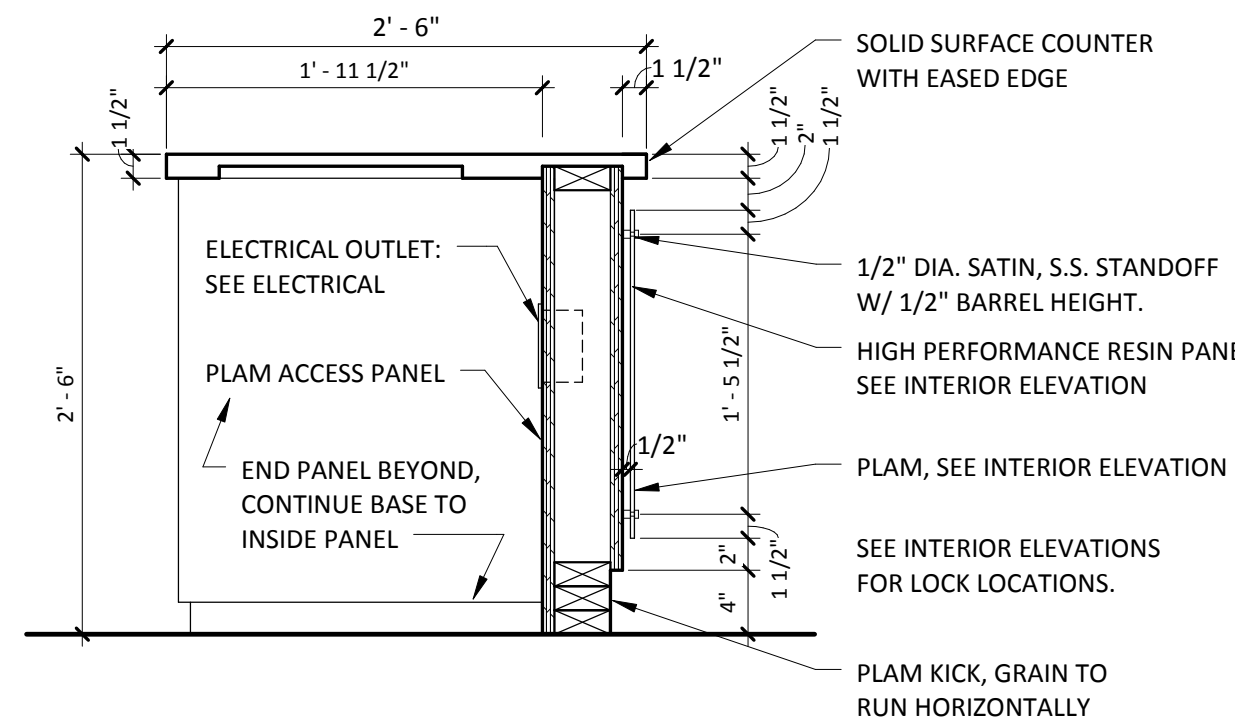


3 CASEWORK TYPE "R03"
A7.4 1" = 1'-0"

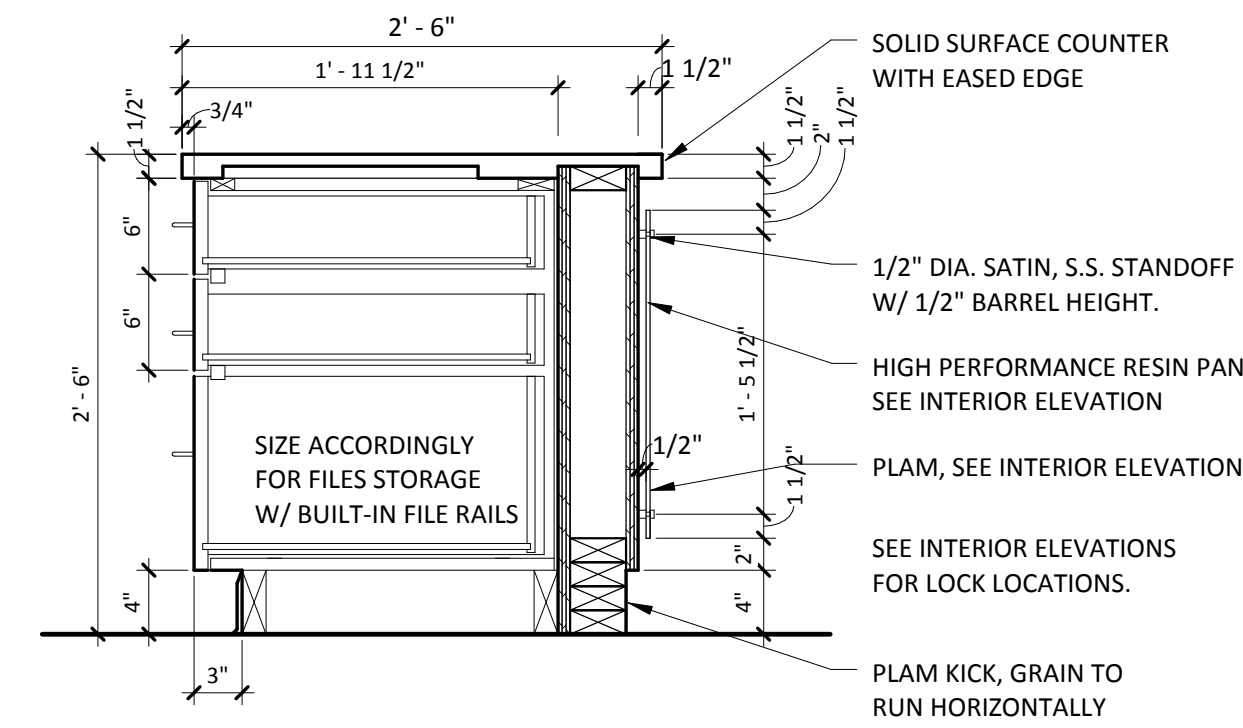


4 CASEWORK TYPE "R04"
A7.4 1" = 1'-0"

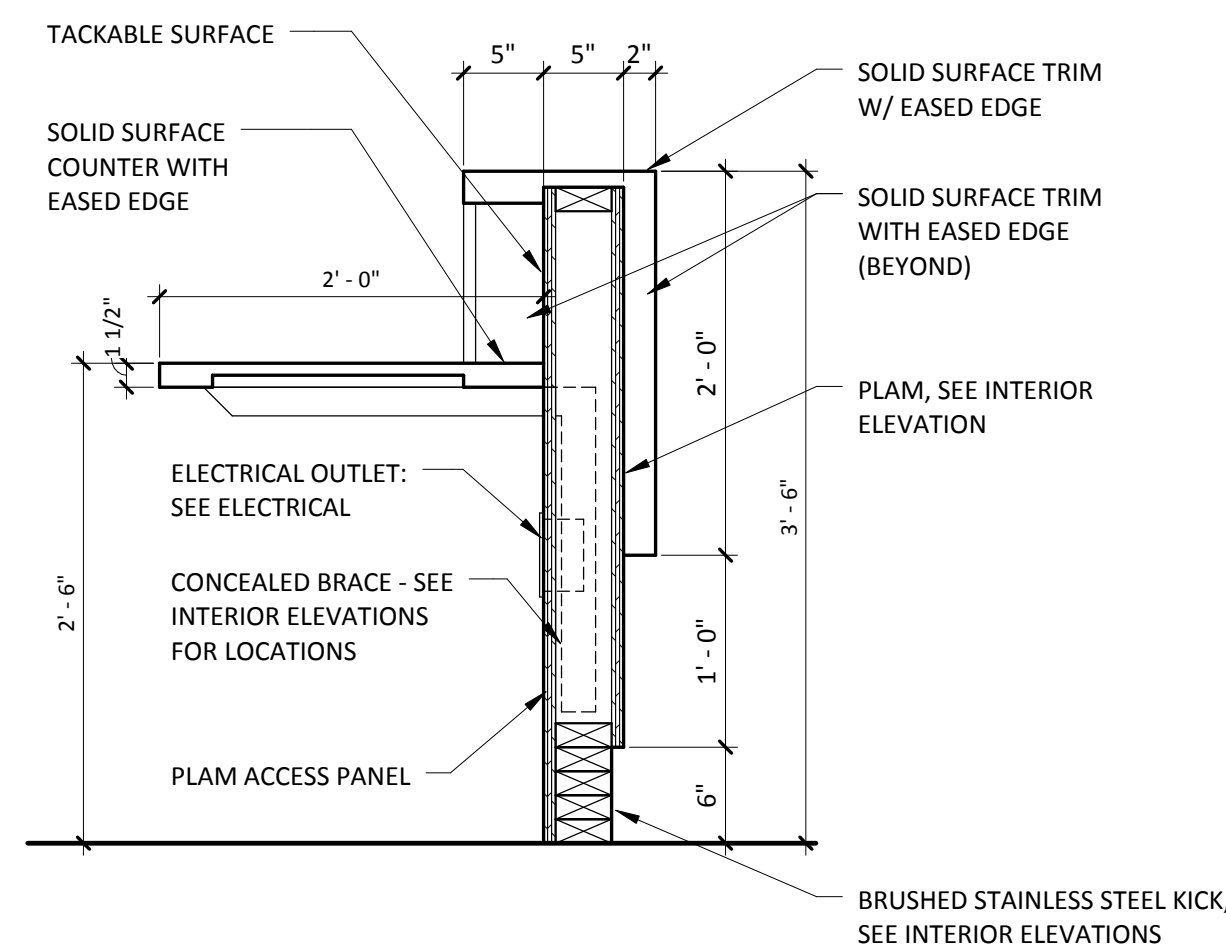


5 CASEWORK TYPE "R21"
A7.4 1" = 1'-0"

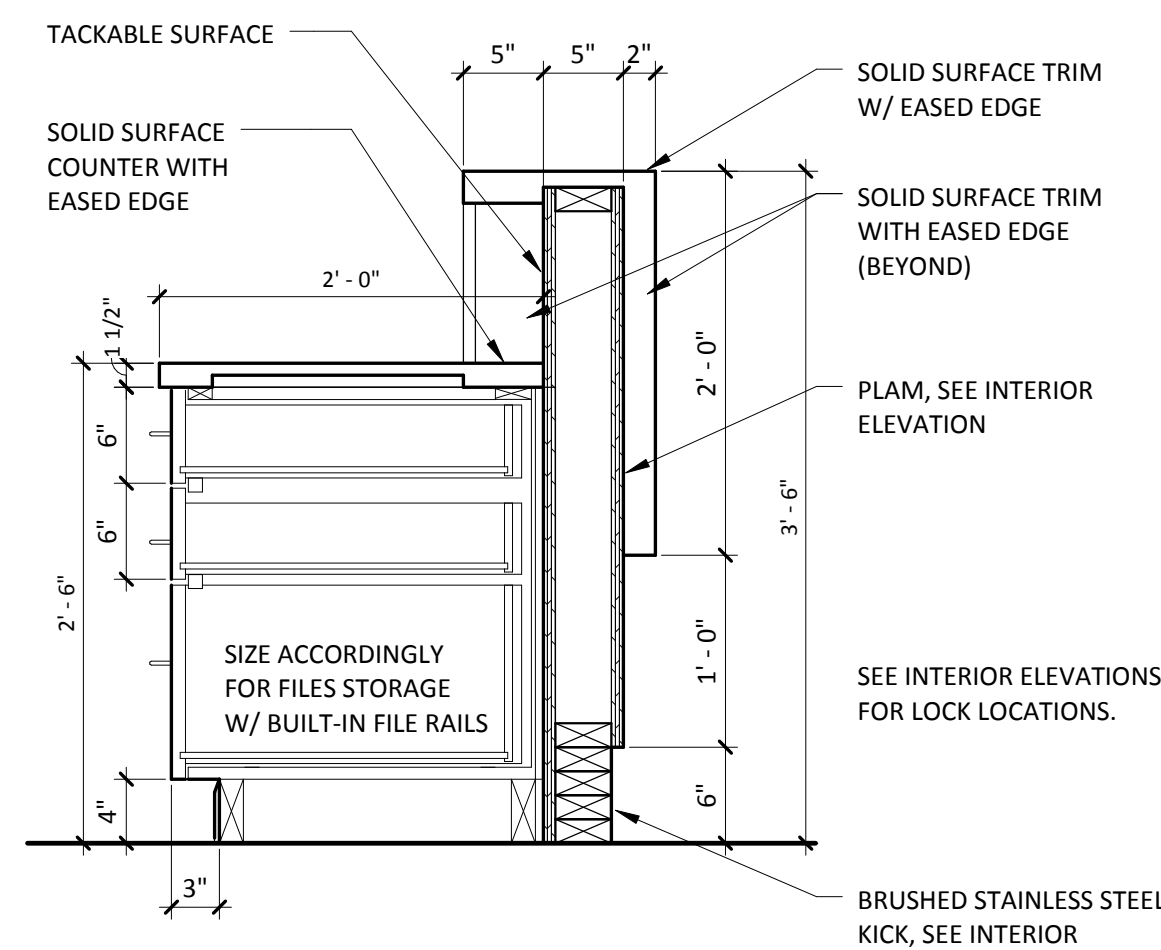


6 CASEWORK TYPE "R22"
A7.4 1" = 1'-0"

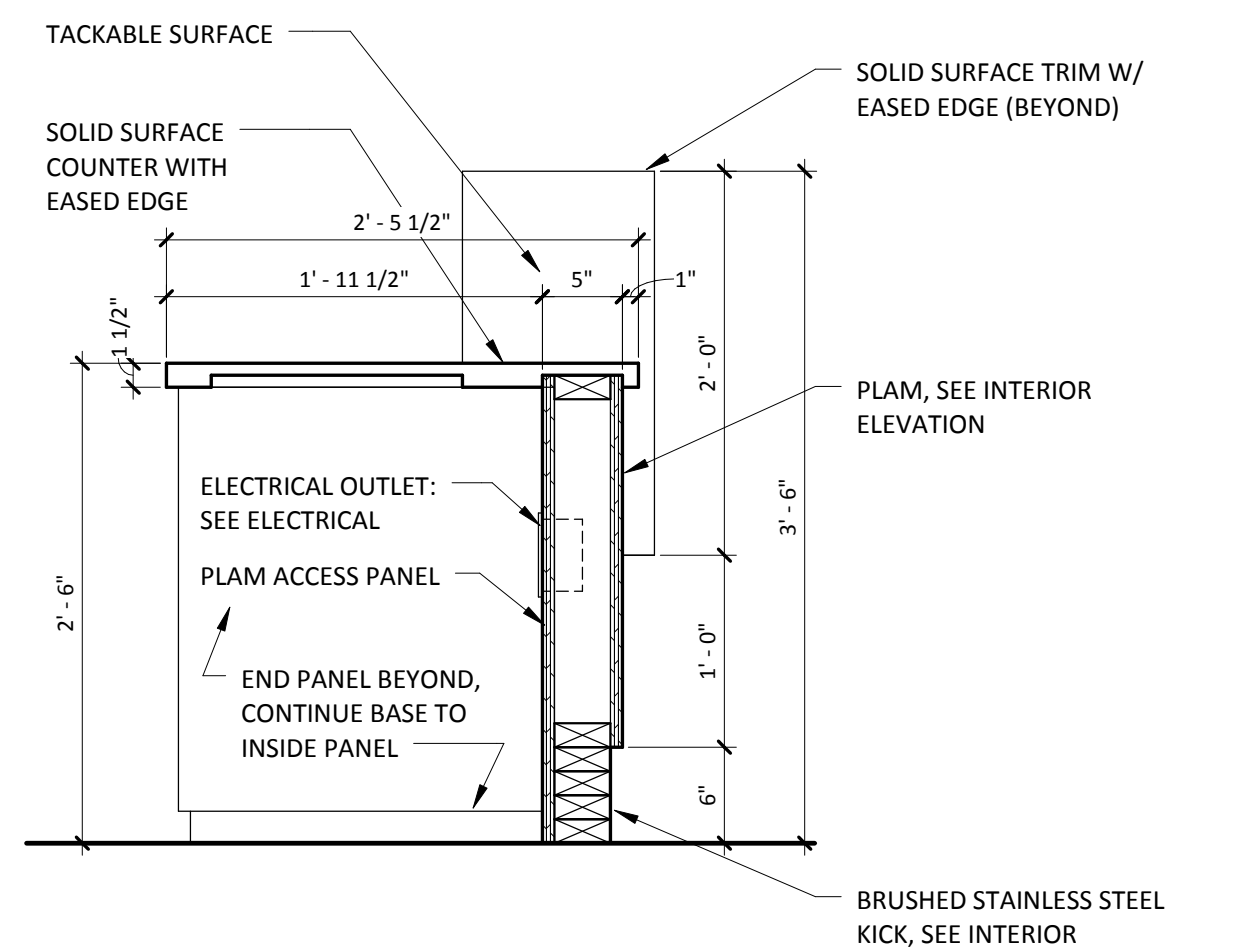


7 CASEWORK TYPE "R23"
A7.4 1" = 1'-0"

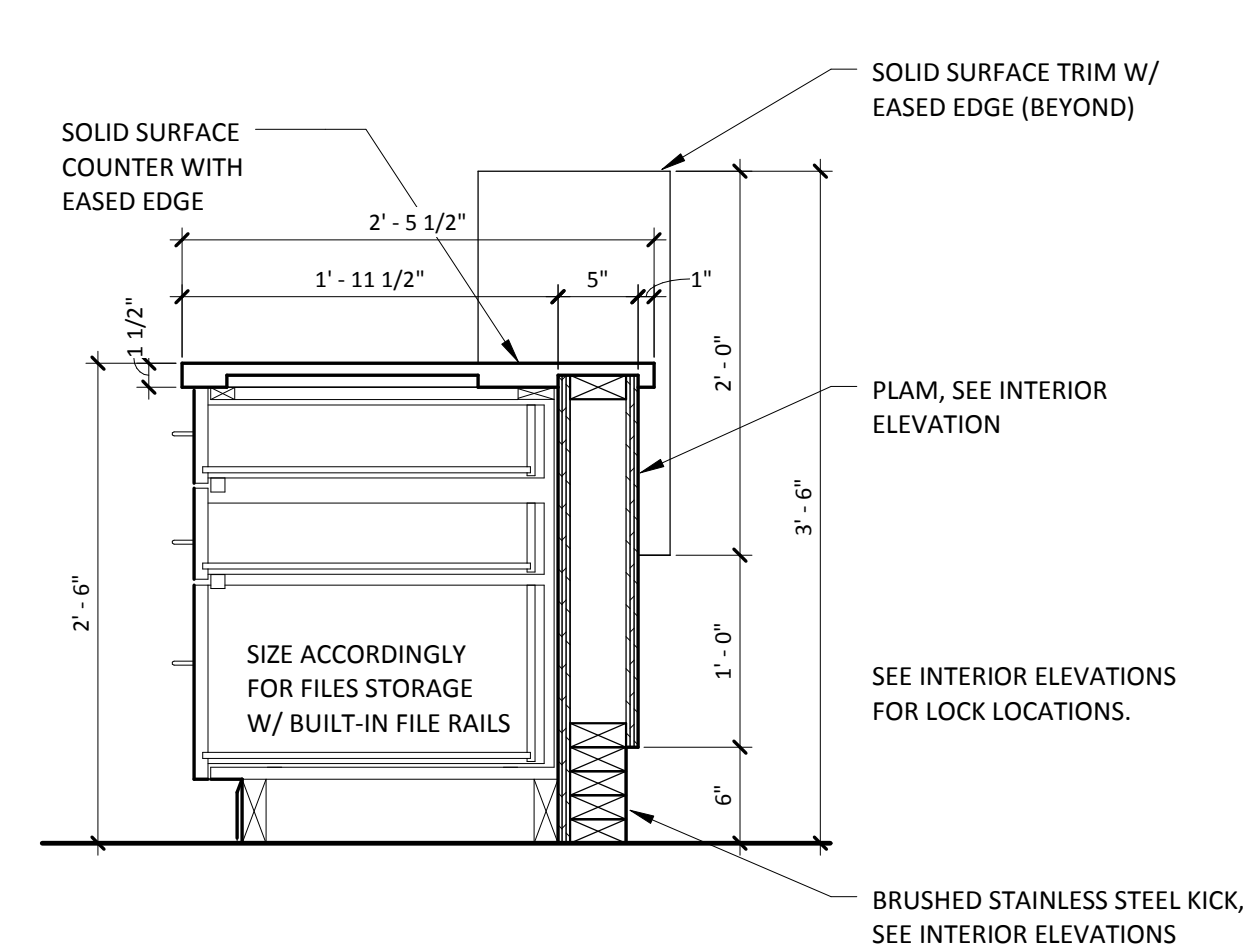


8 CASEWORK TYPE "R24"
A7.4 1" = 1'-0"

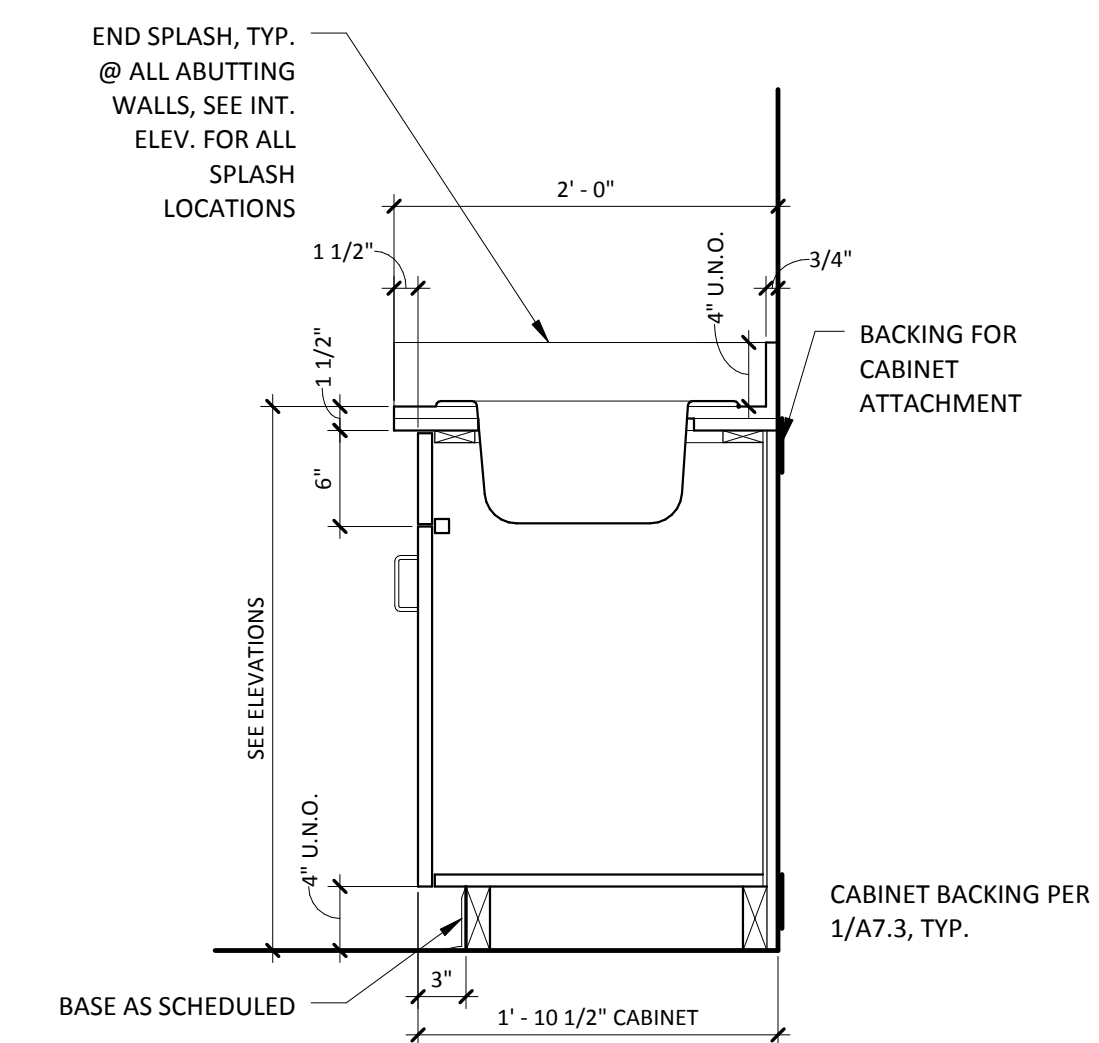


9 CASEWORK TYPE "S03"
A7.4 1" = 1'-0"

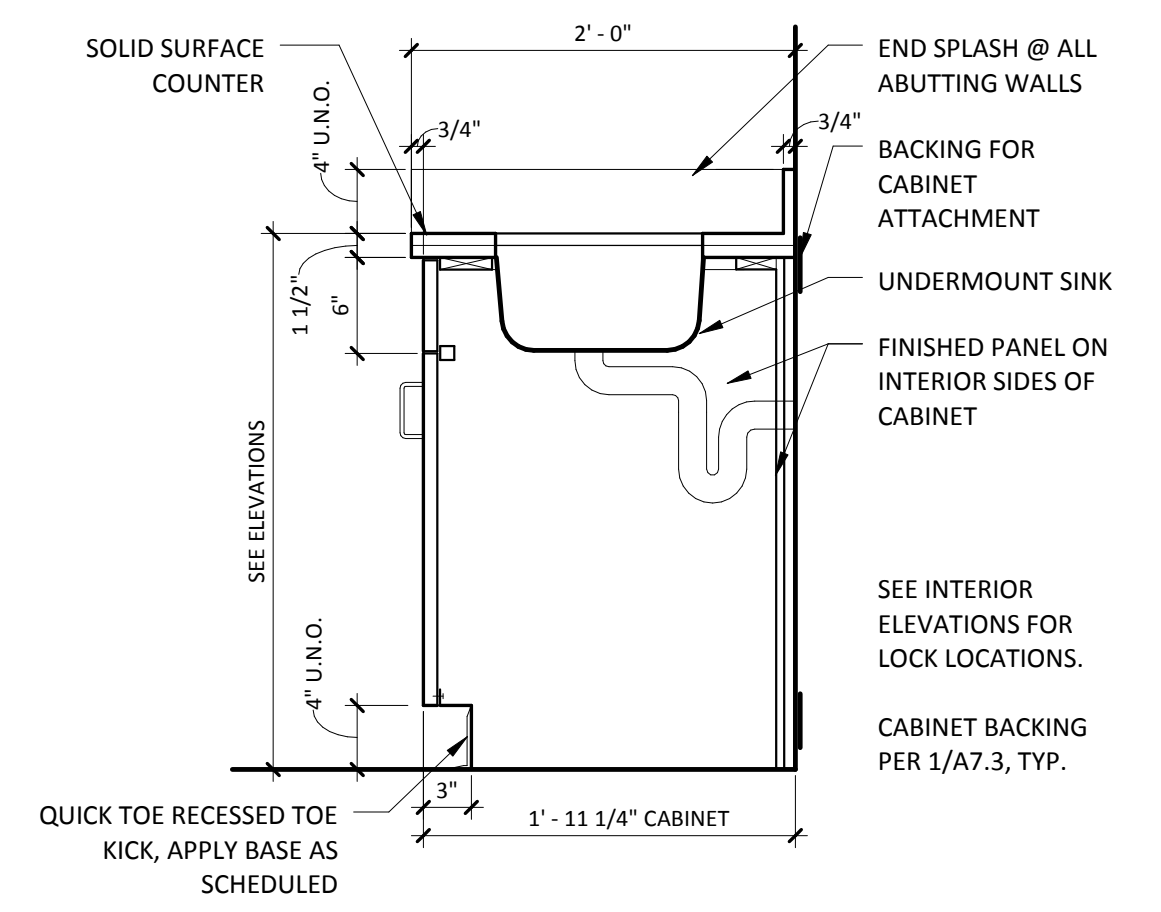


10 CASEWORK TYPE "S04"
A7.4 1" = 1'-0"

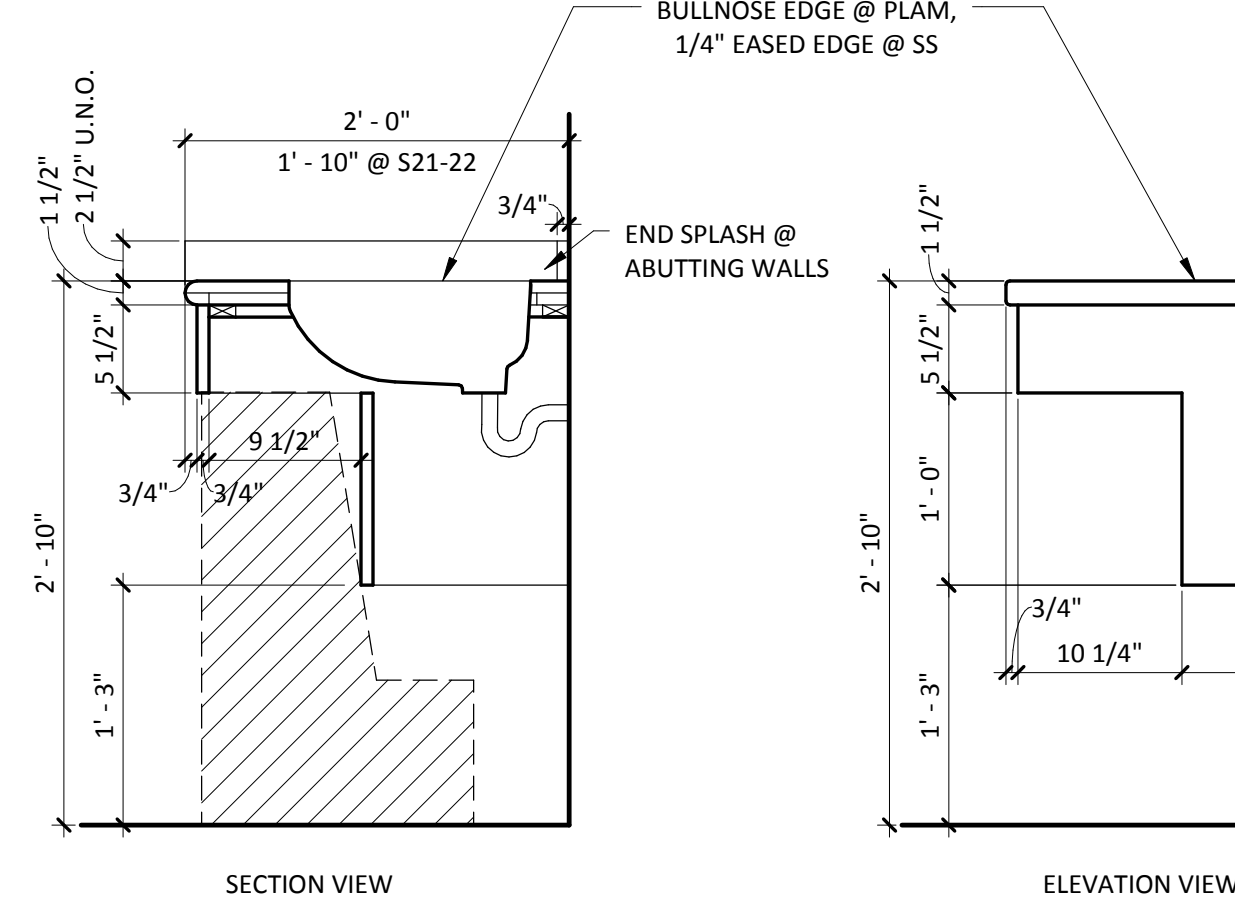


11 CASEWORK TYPE "S21" & "S-21-22"
A7.4 1" = 1'-0"

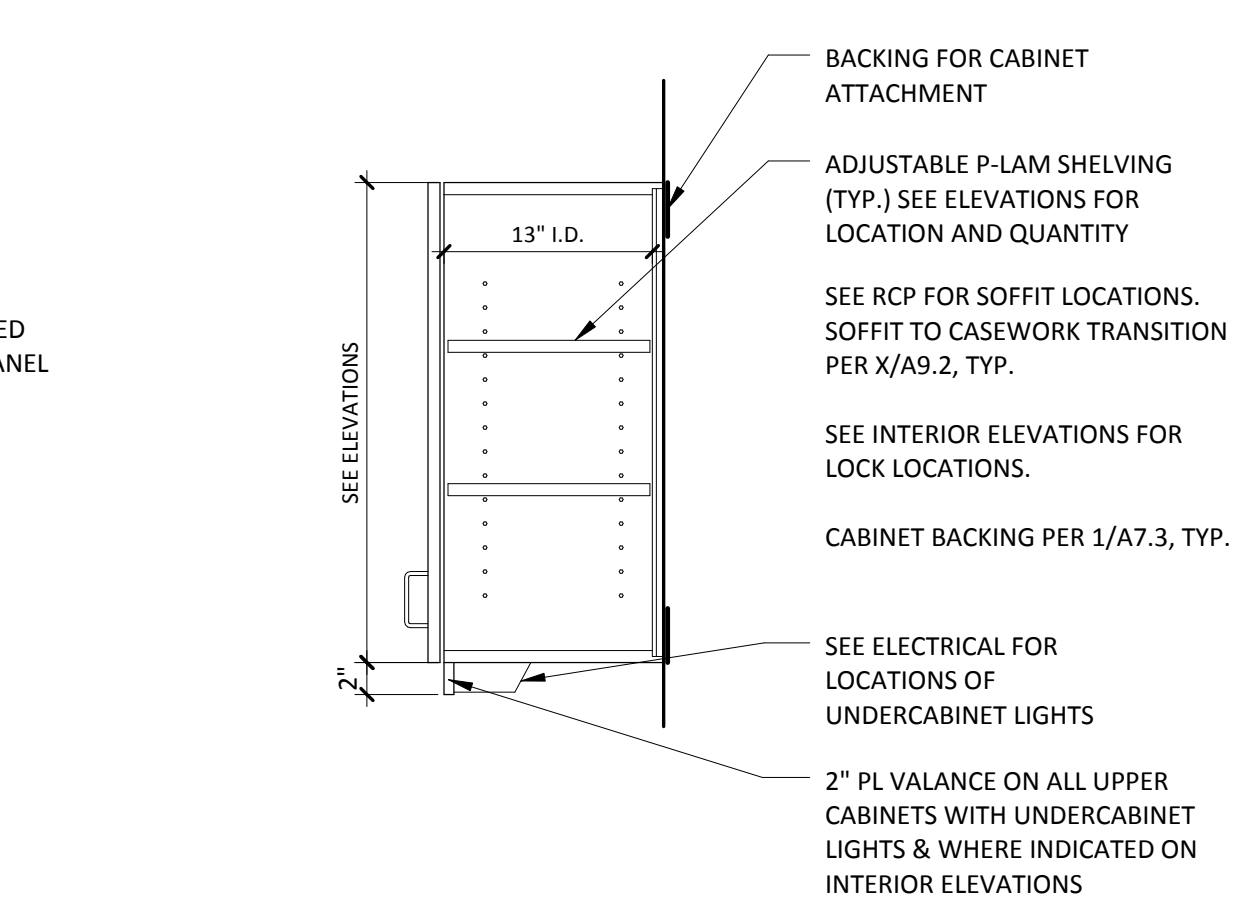


12 CASEWORK TYPE "W01"
A7.4 1" = 1'-0"

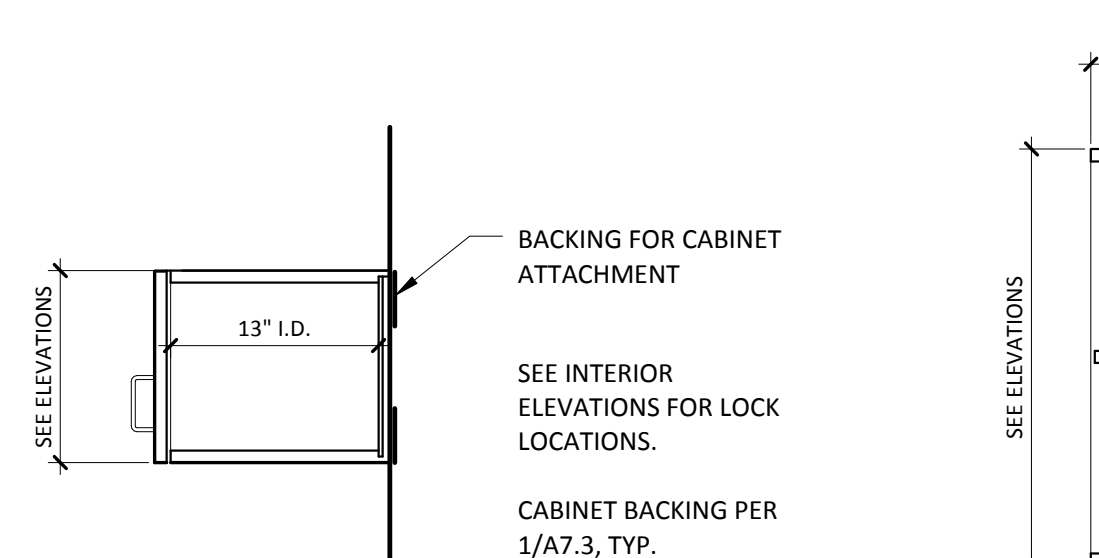


13 CASEWORK TYPE "W02"
A7.4 1" = 1'-0"

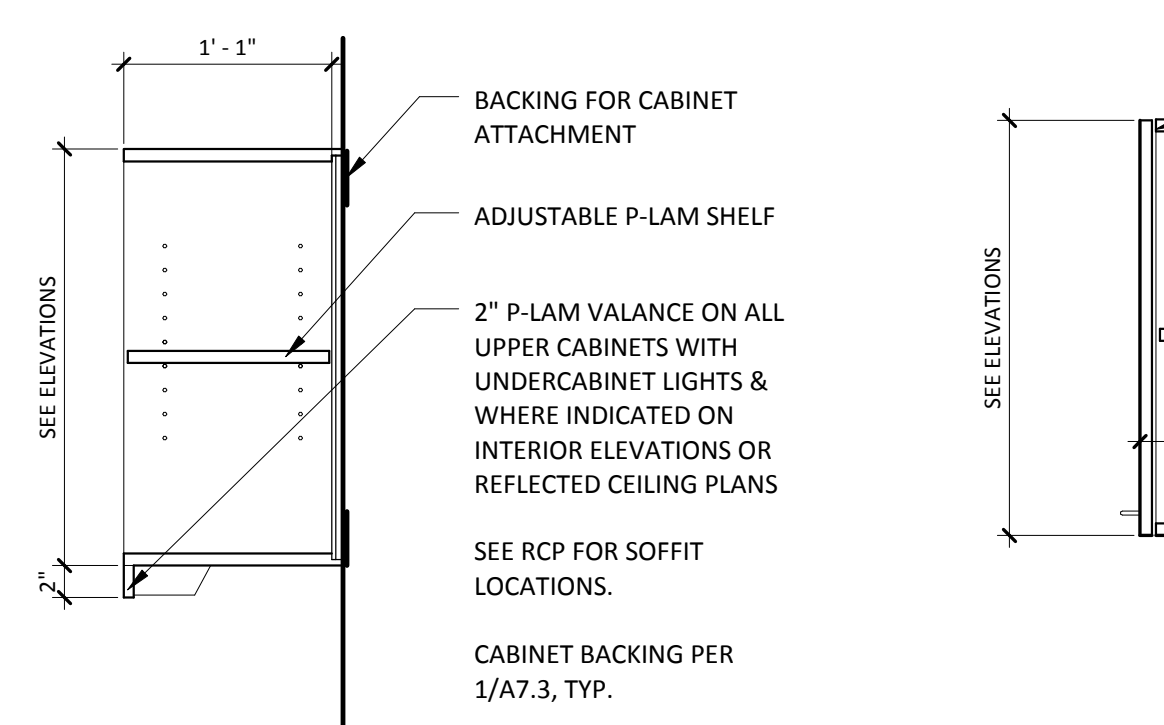


14 CASEWORK TYPE "W04"
A7.4 1" = 1'-0"

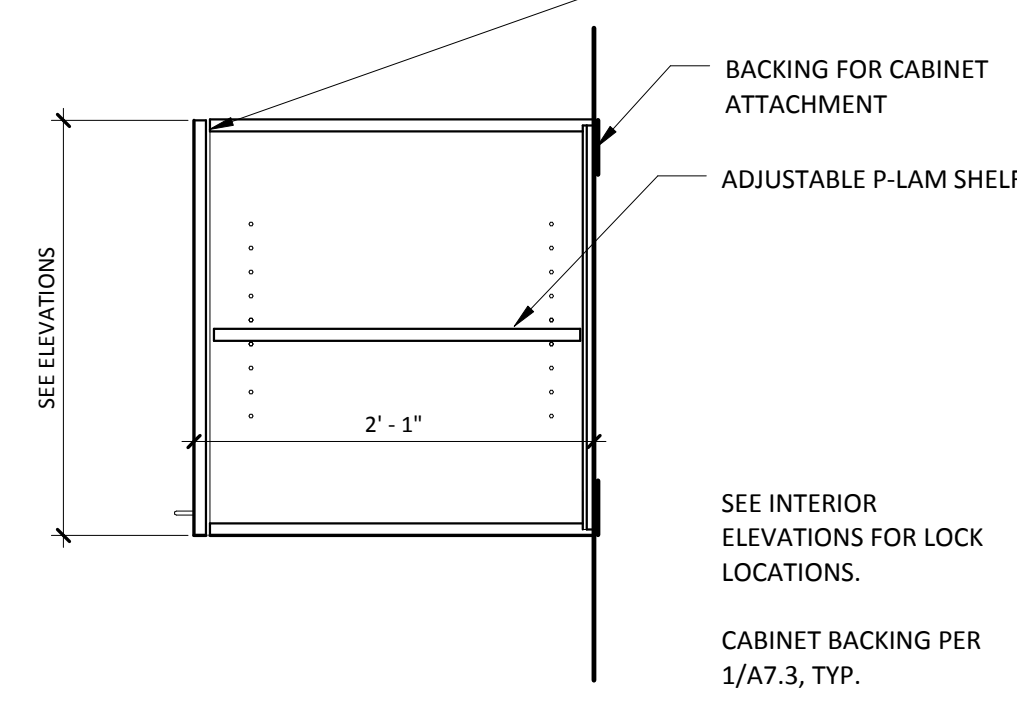


15 CASEWORK TYPE "W05"
A7.4 1" = 1'-0"

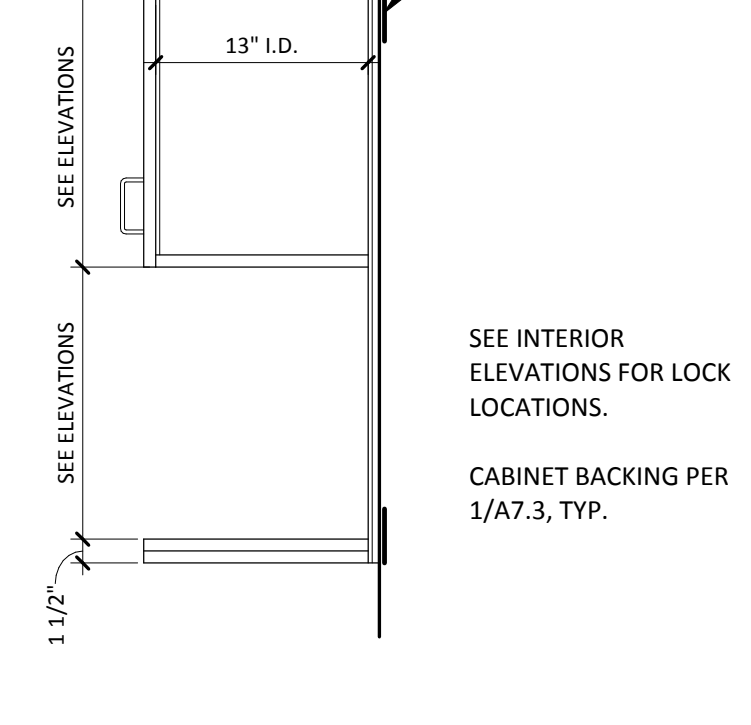

16 CASEWORK TYPE "W06"
A7.4 1" = 1'-0"

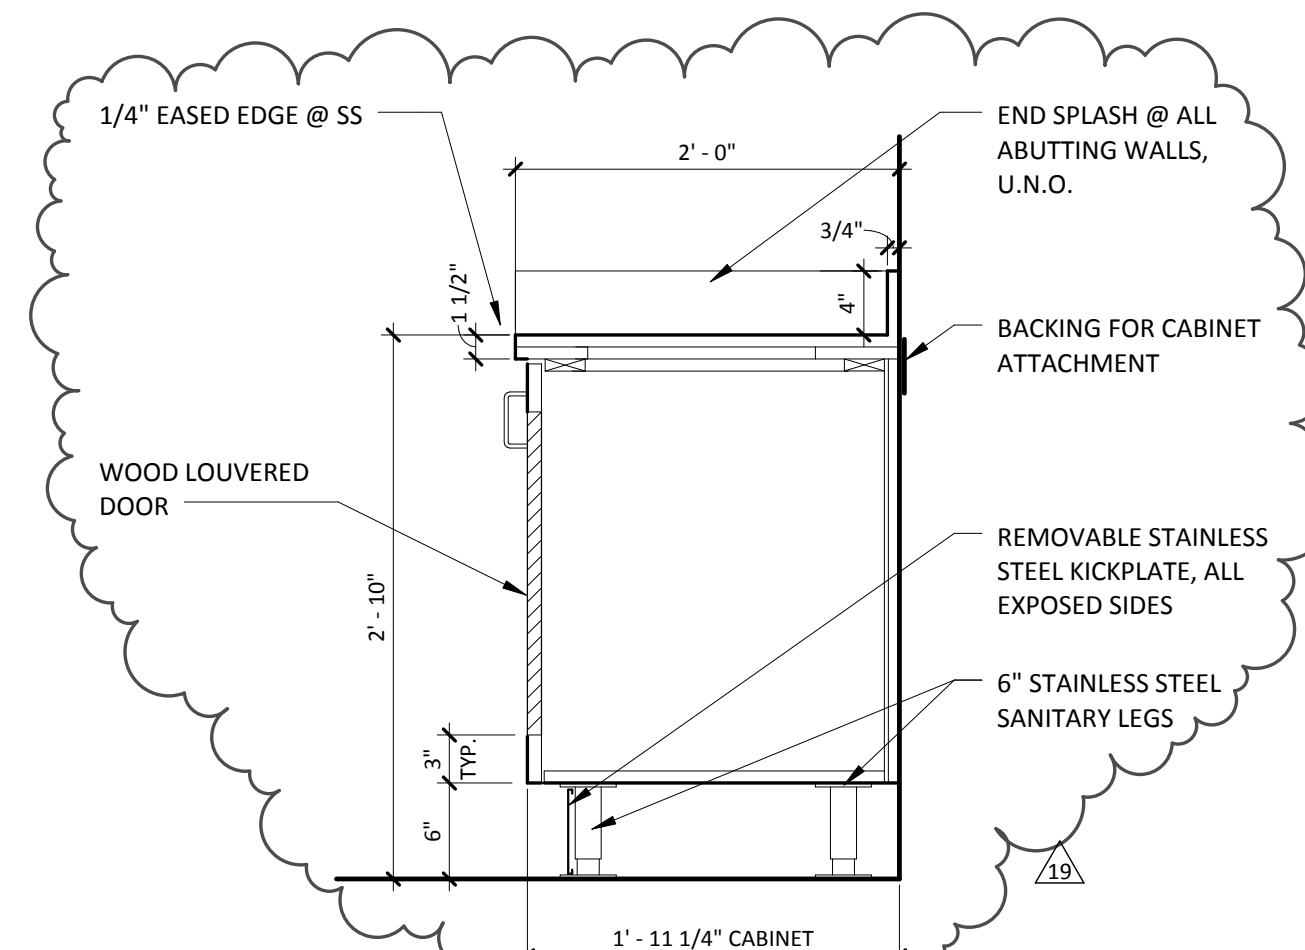

17 CASEWORK TYPE "B26"
A7.4 1" = 1'-0"

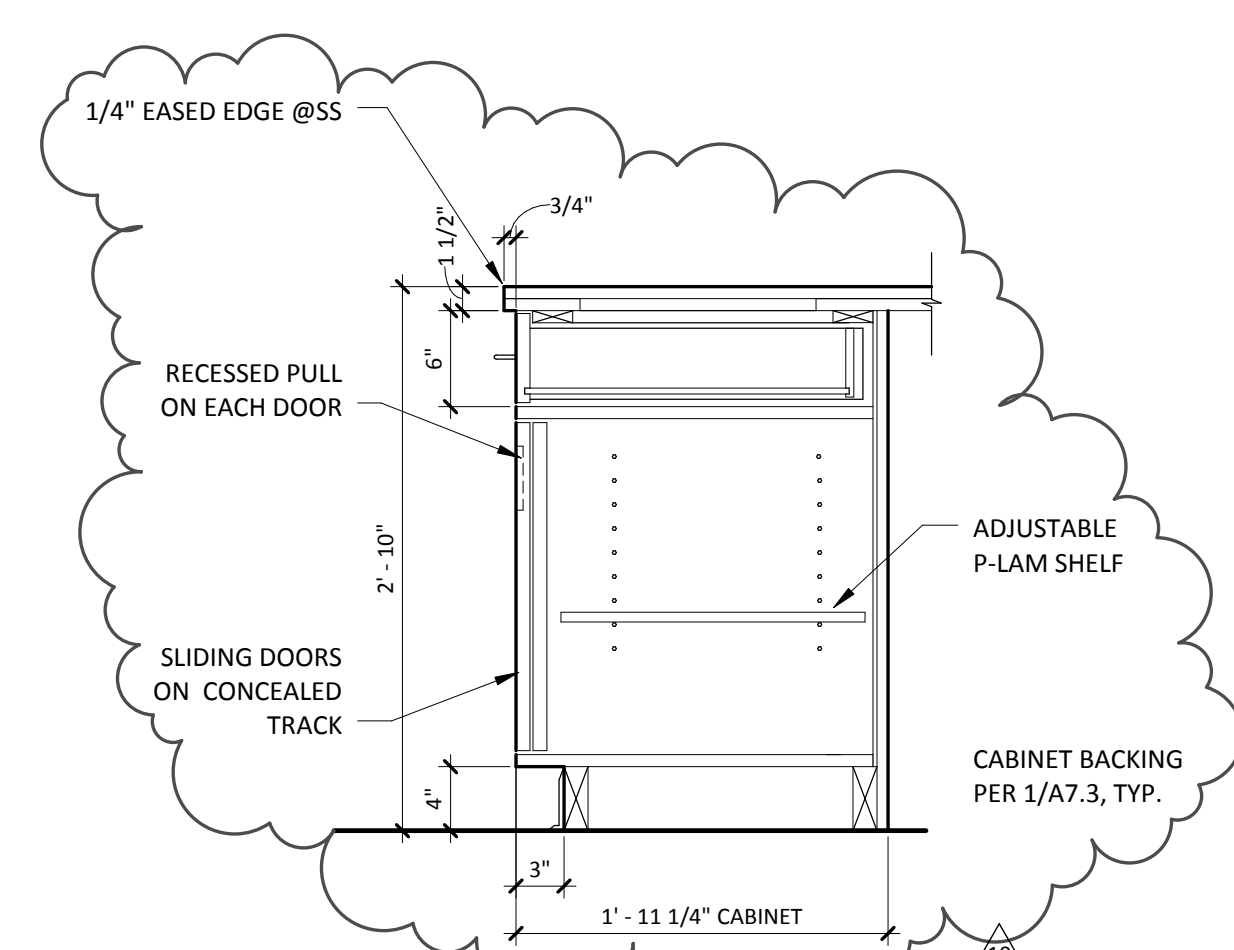

18 CASEWORK TYPE "B27"
A7.4 1" = 1'-0"

BOULDER ASSOCIATES

ARCHITECTS

Boulder Associates, Inc.
Architecture + Interior Design
1426 Pearl Street, Suite 300
Boulder, Colorado 80302
303.499.7795 F 303.499.7767
www.boulderassociates.com


PROJECT
ERC RESIDENTIAL PROGRAM & PHP

98 Spruce Street
Denver, CO 80230


SHEET TITLE
CASEWORK SECTIONS

SHEET NUMBER


A7.4

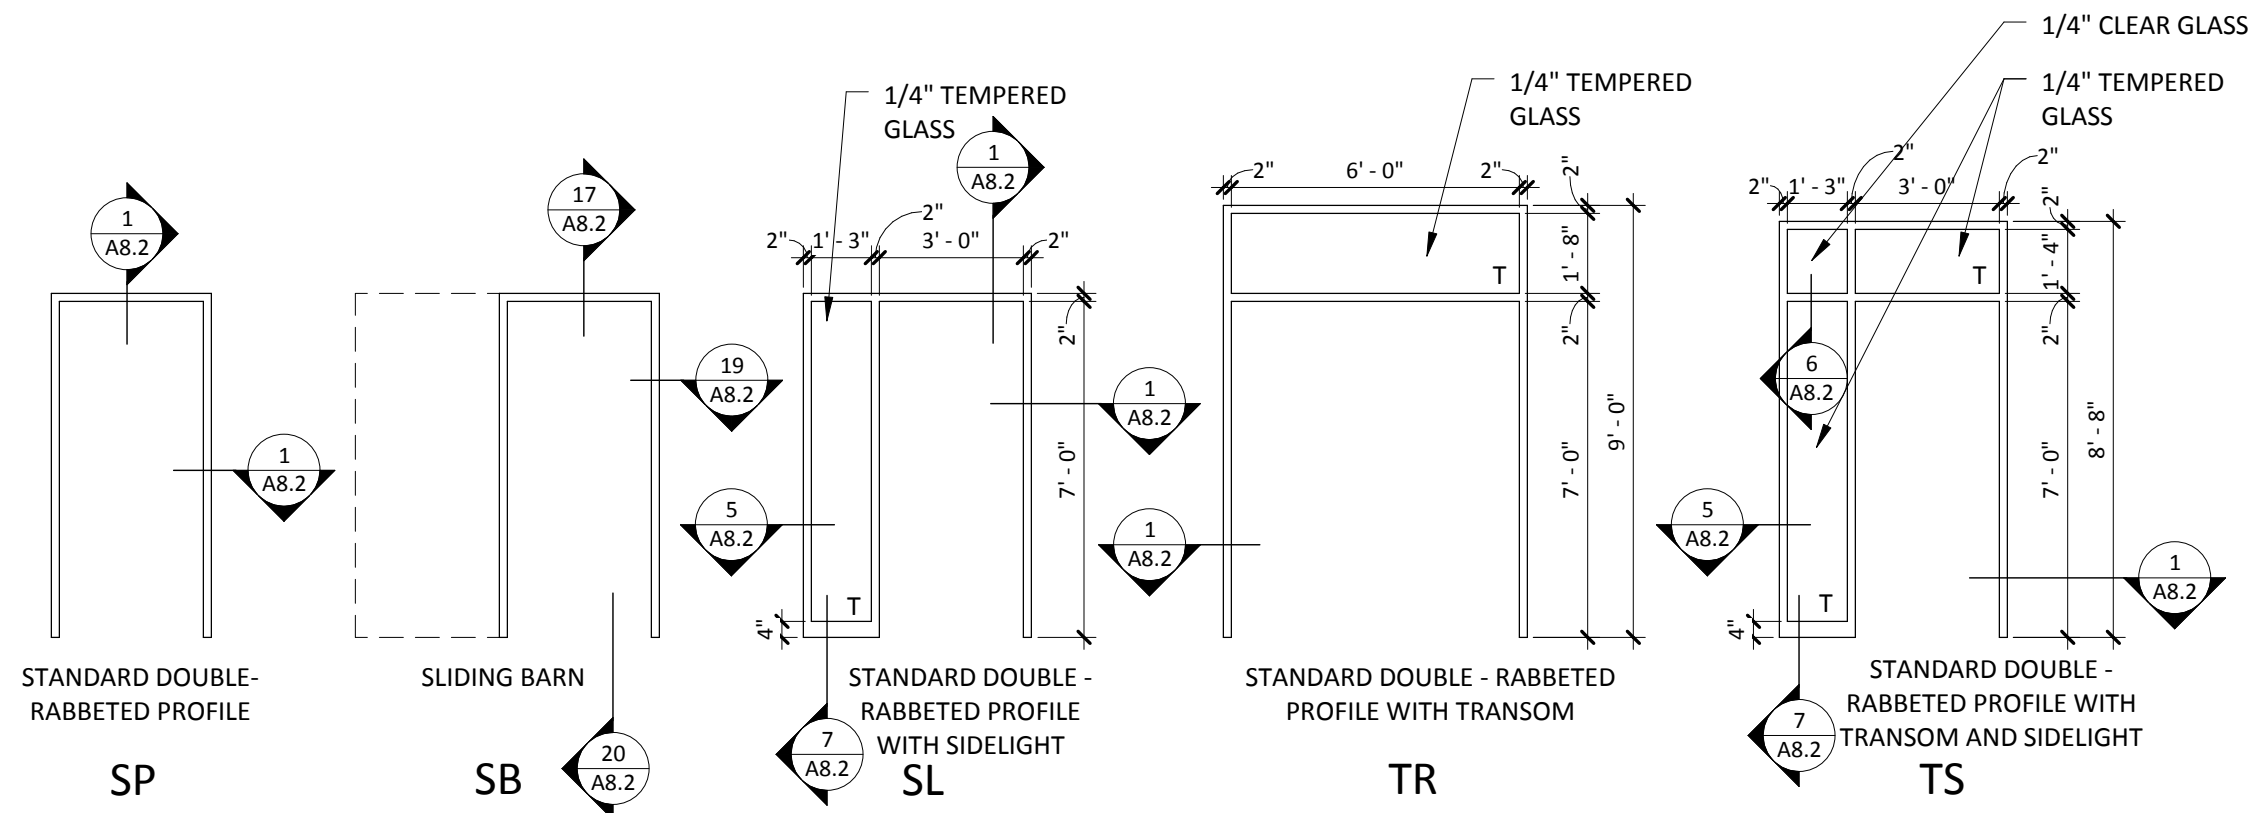


DOOR FRAME TYPES

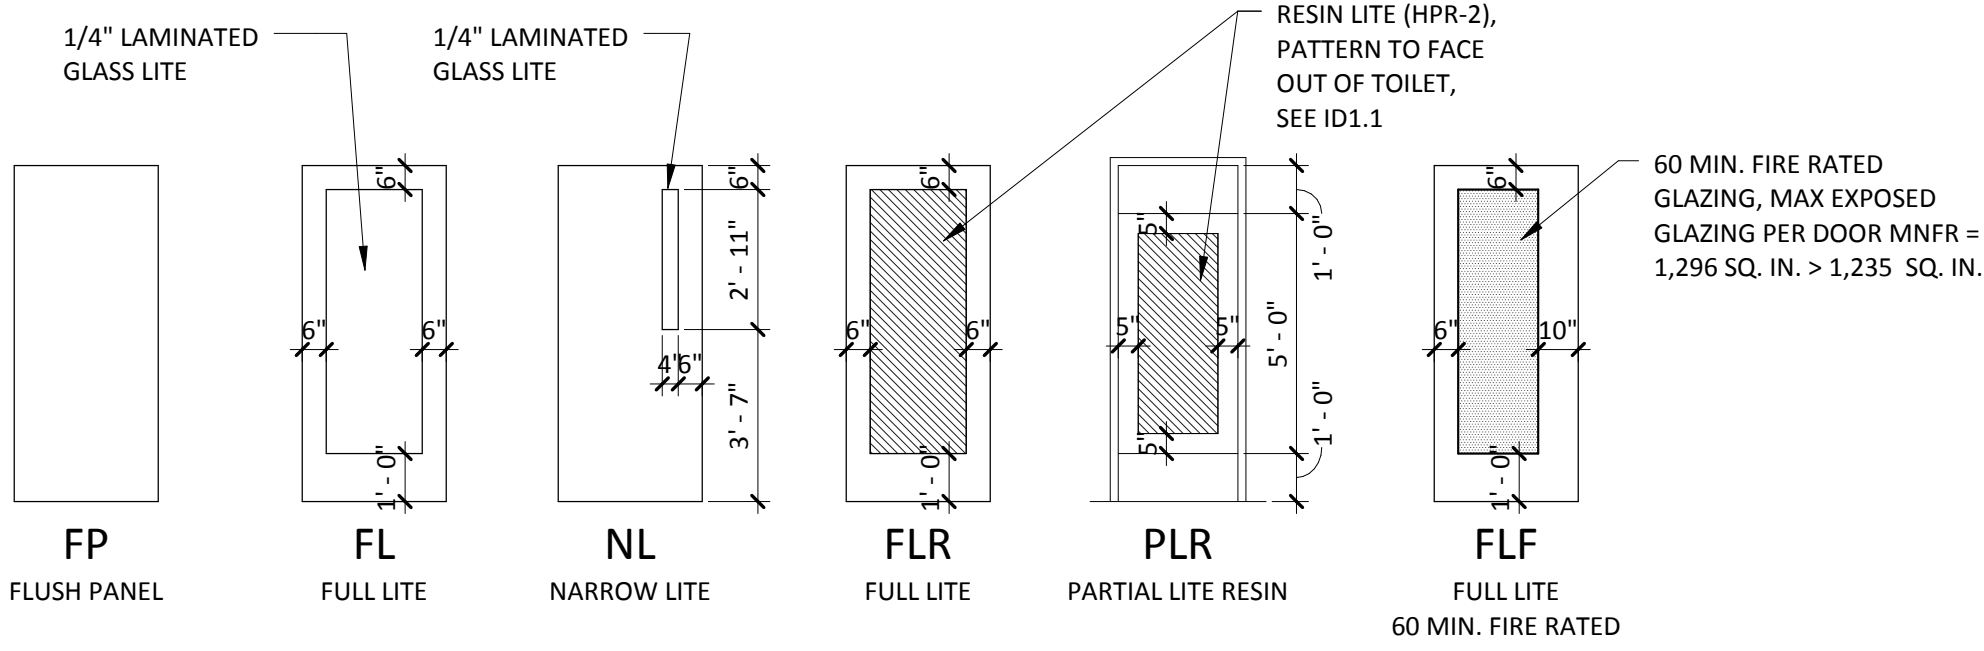


DOOR TYPES

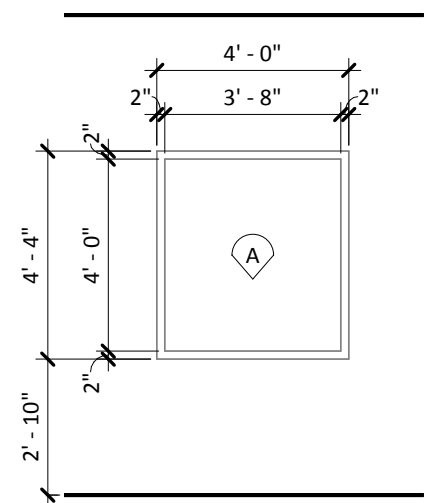


WINDOW TYPE 'A'

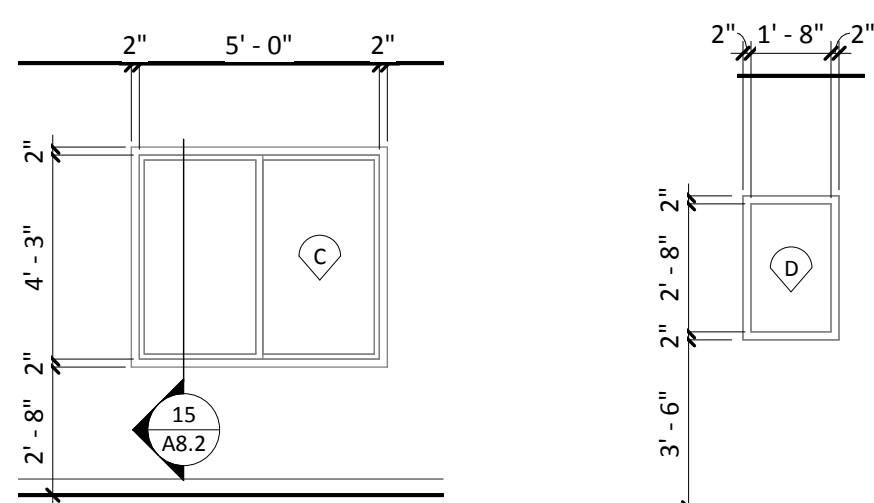


WINDOW TYPE 'C'

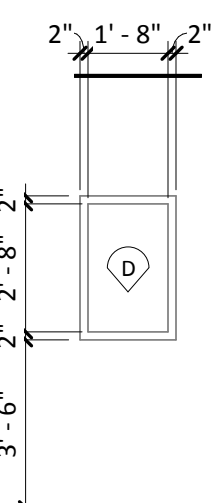


WINDOW TYPE 'D'

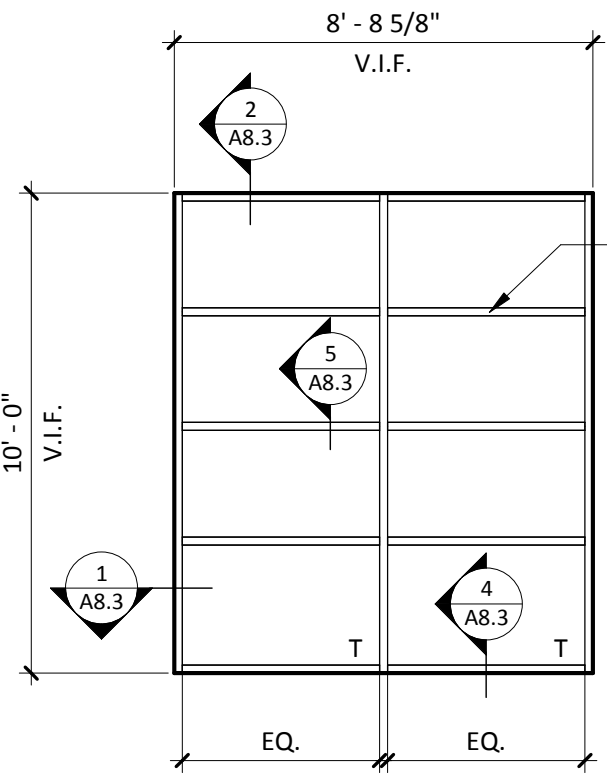


WINDOW TYPE 'E1'

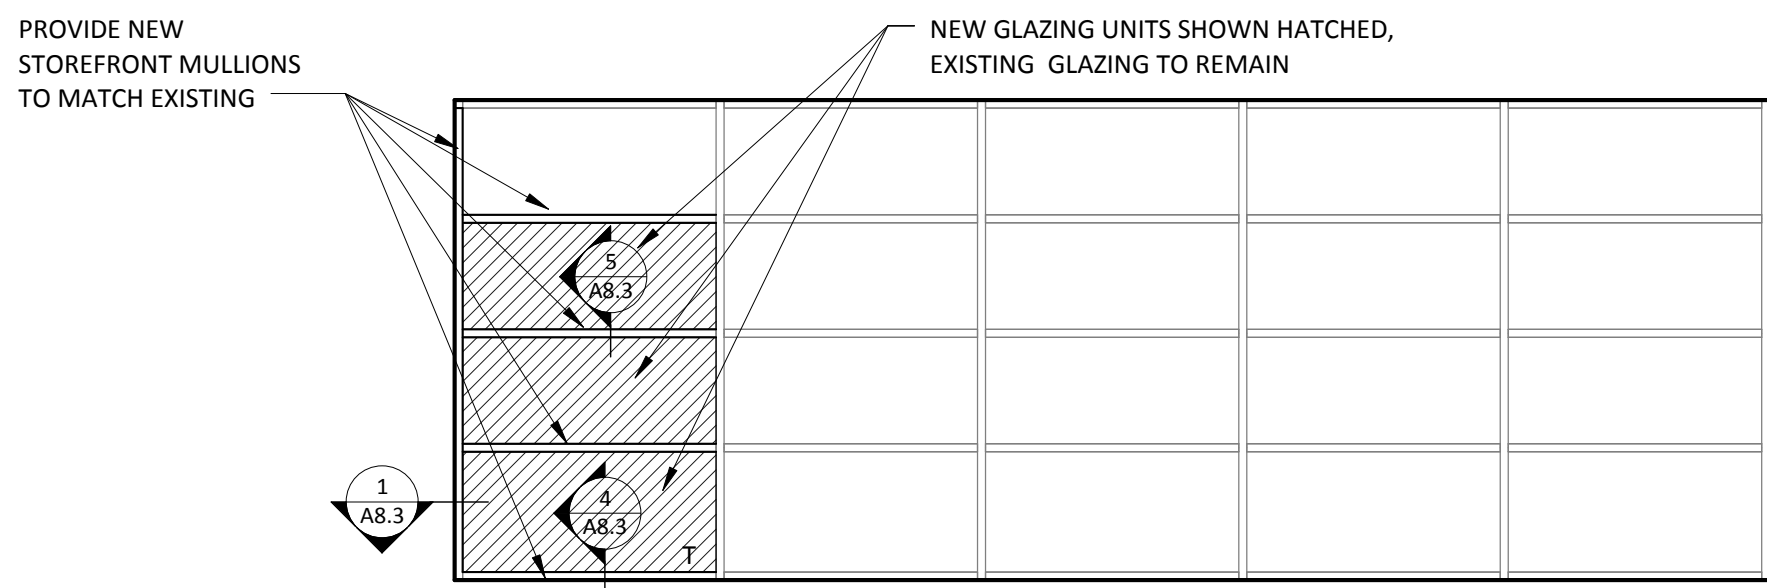

WINDOW TYPE 'E2'

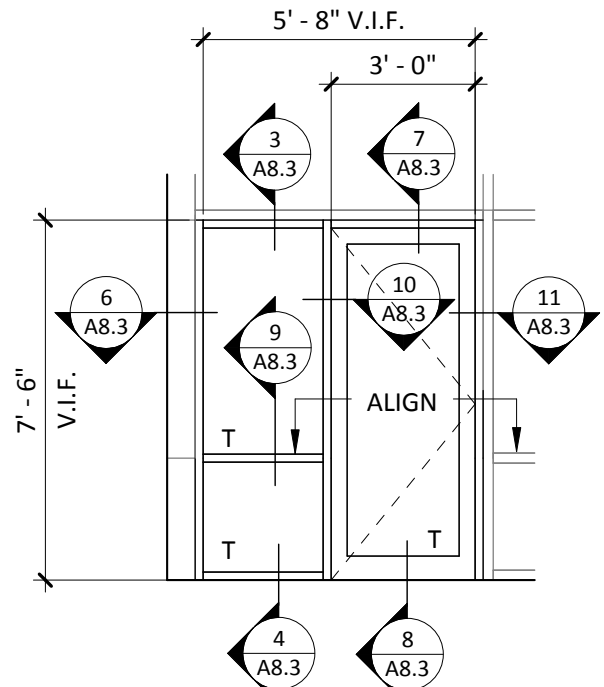


WINDOW TYPE 'E3'

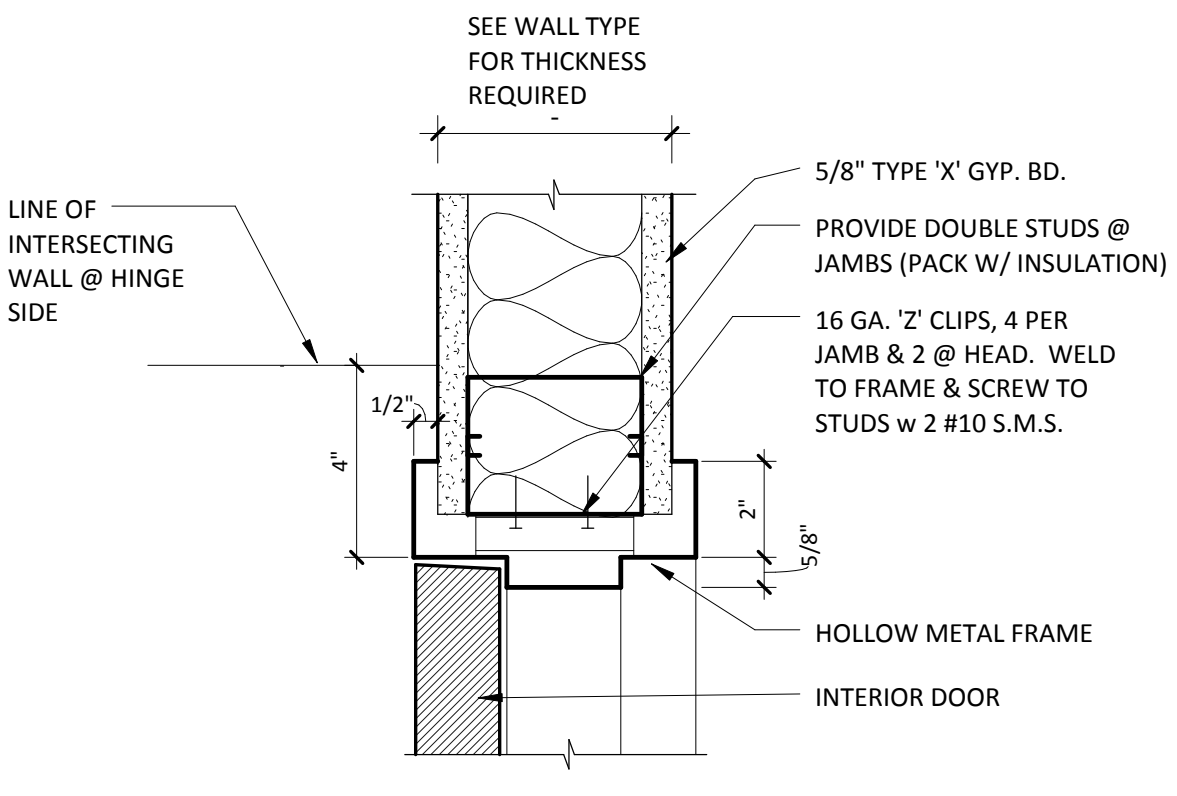


1 TYP. HM JAMB (HEAD SIM.)

A8.2 | A8.2 3" = 1'-0"

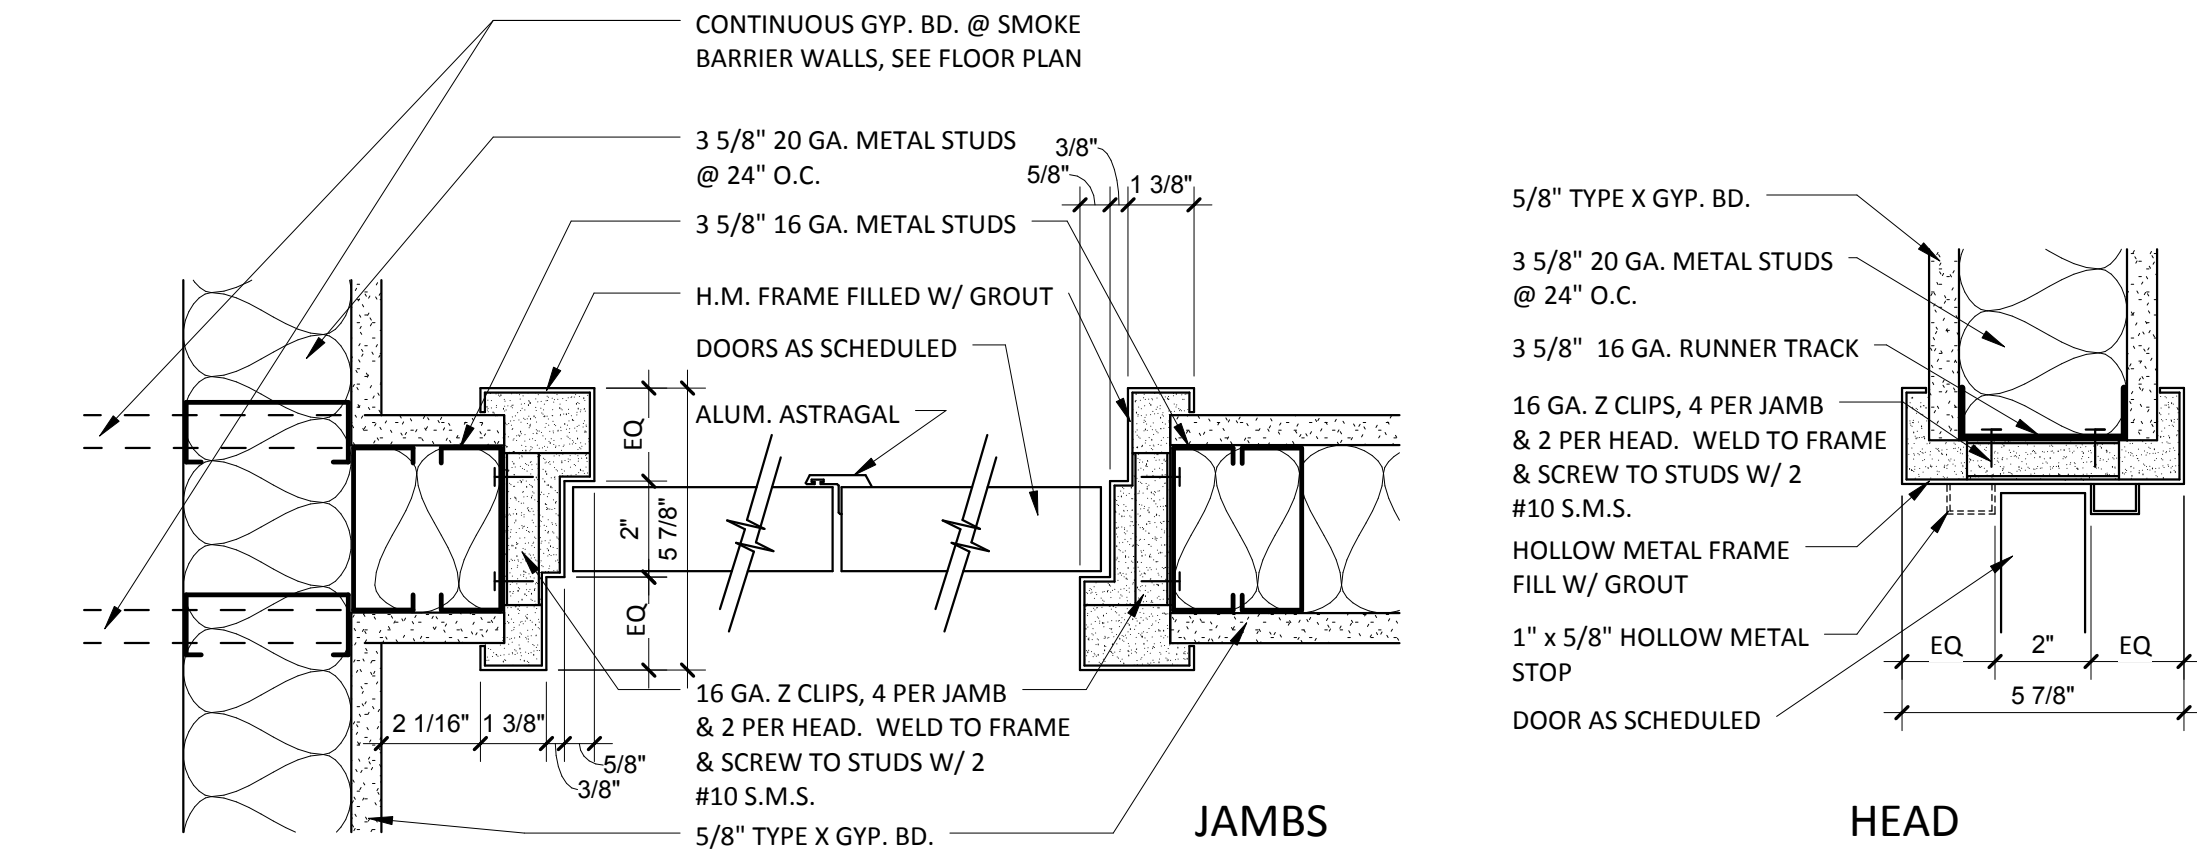


2 DOUBLE EGRESS DOOR FRAME DETAIL

A8.2 | A8.2 3" = 1'-0"

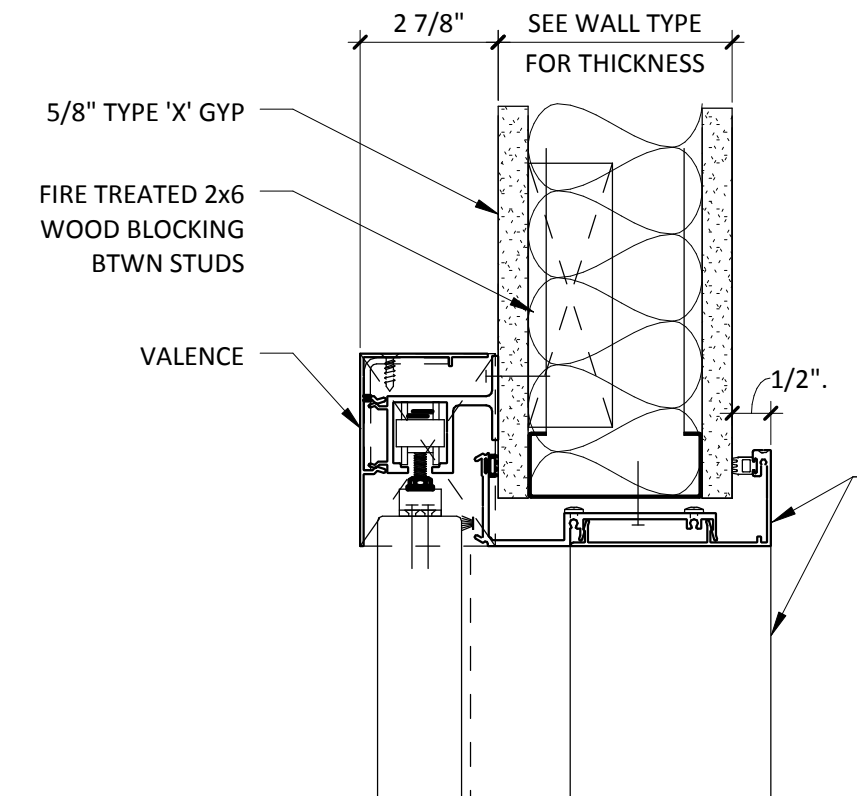


17 BARN DOOR @ HEADER

A8.2 | A8.2 3" = 1'-0"

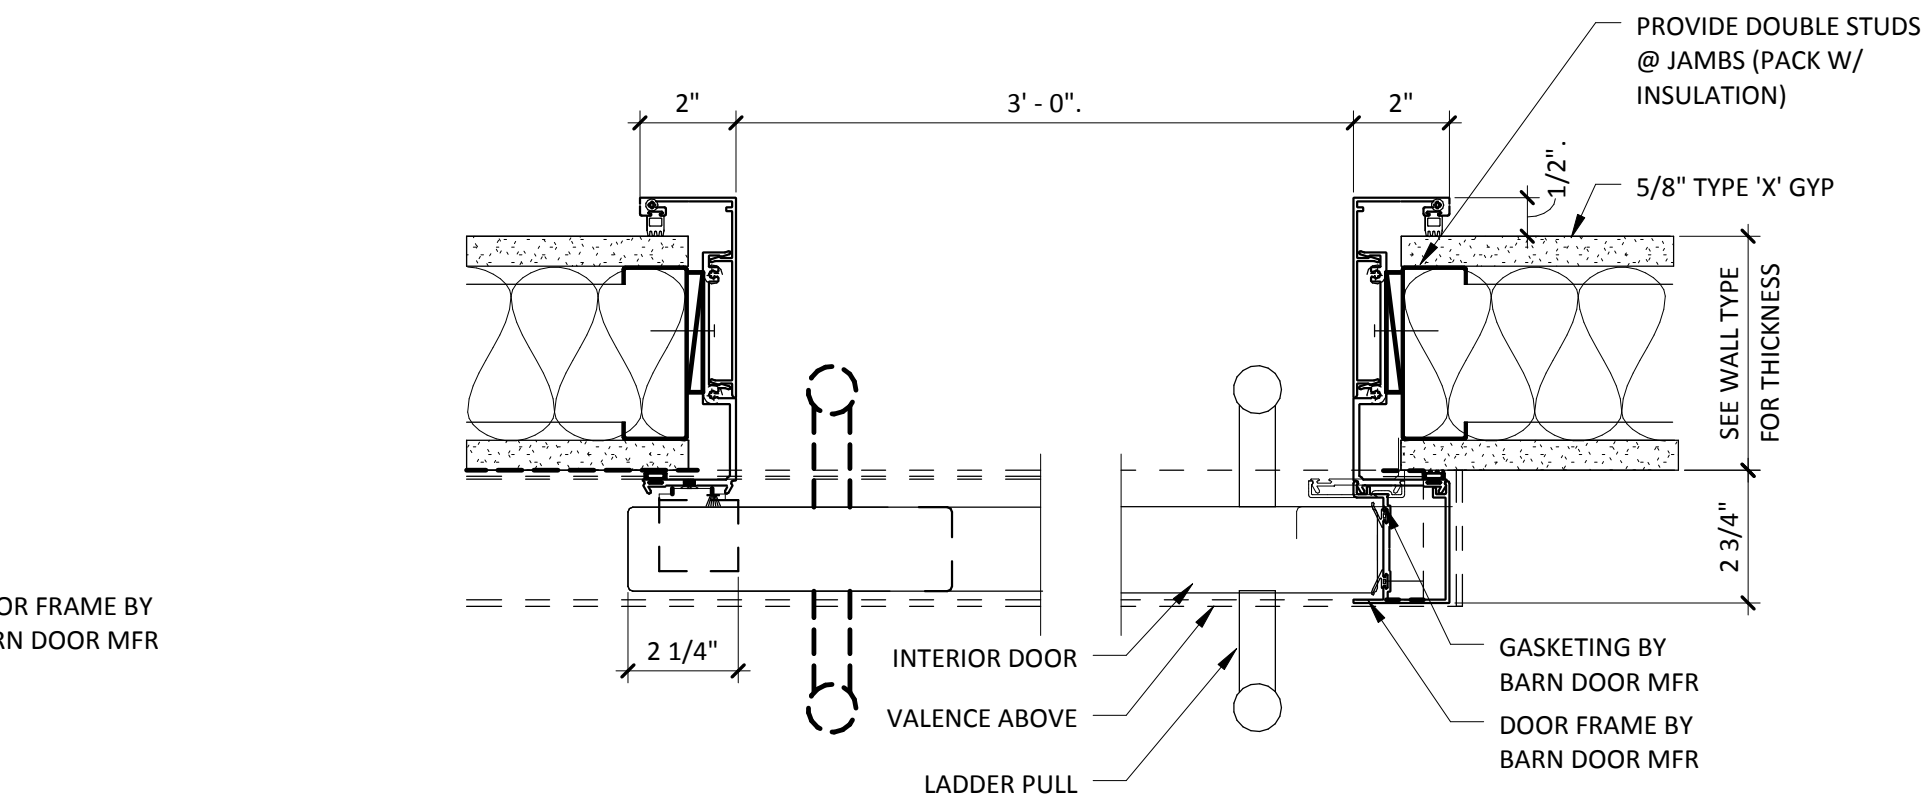


19 BARN DOOR @ JAMB

A8.2 | A8.2 3" = 1'-0"

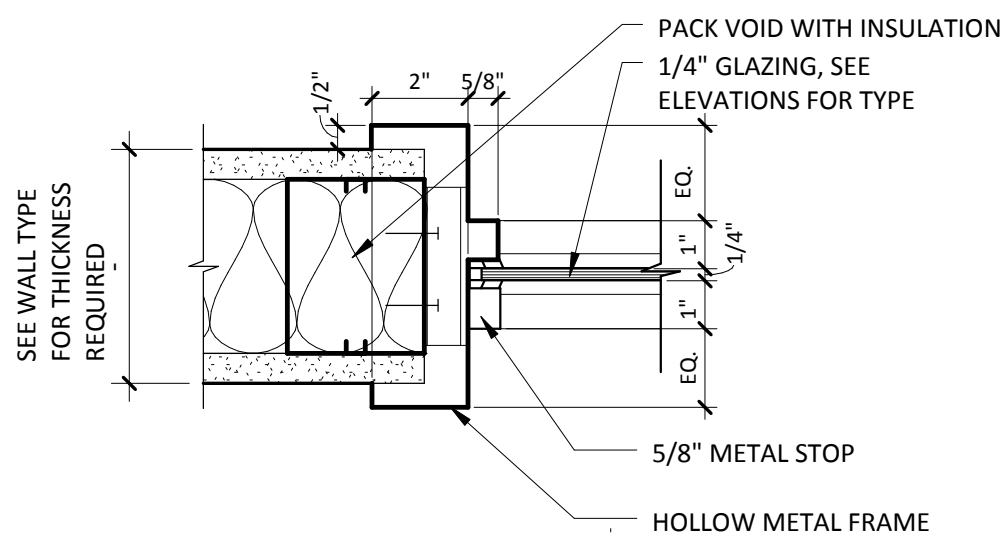


5 TYP. HM LITE

A8.2 | A8.2 3" = 1'-0"

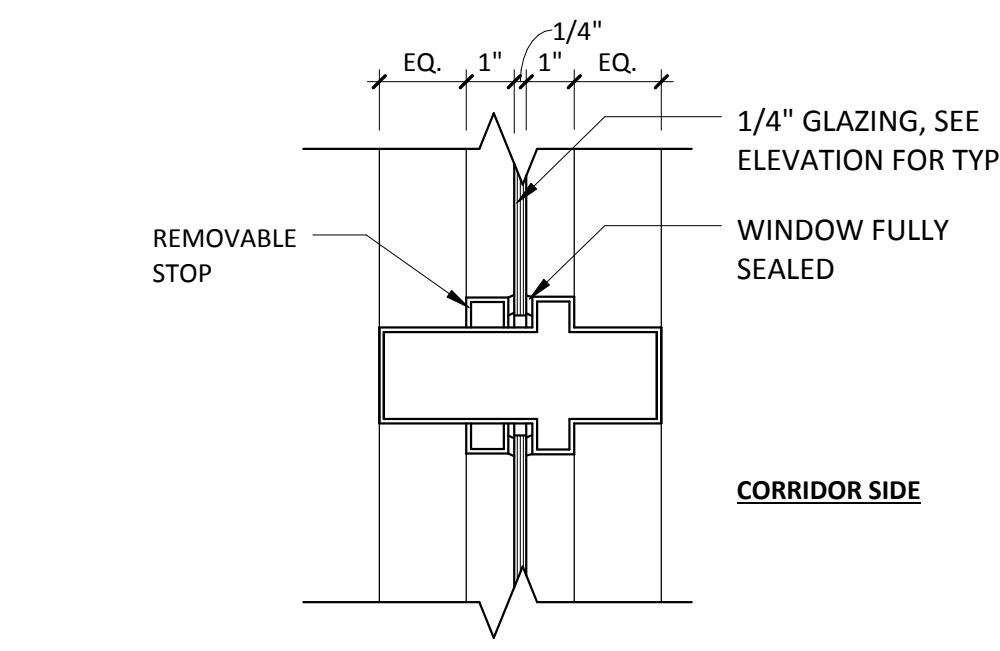


6 HM WINDOW MULLION - HORIZONTAL

A8.2 | A8.2 3" = 1'-0"

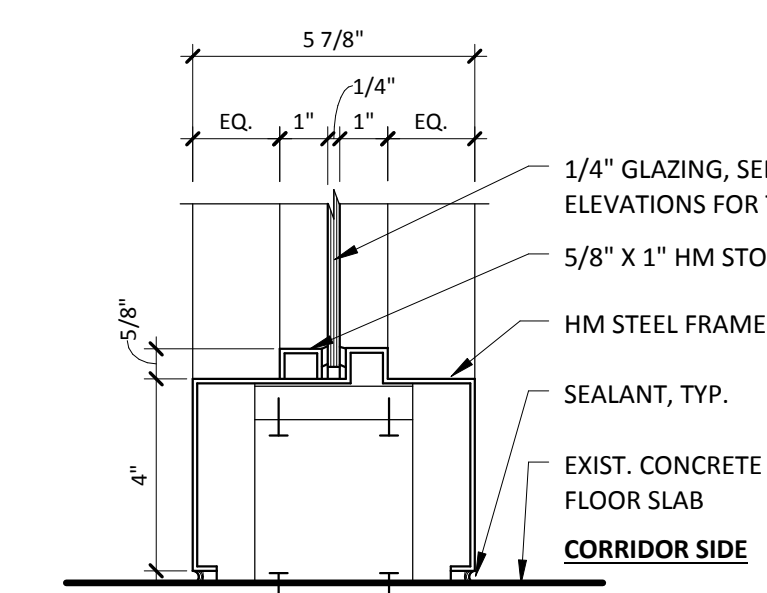


7 HM WINDOW SILL

A8.2 | A8.2 3" = 1'-0"

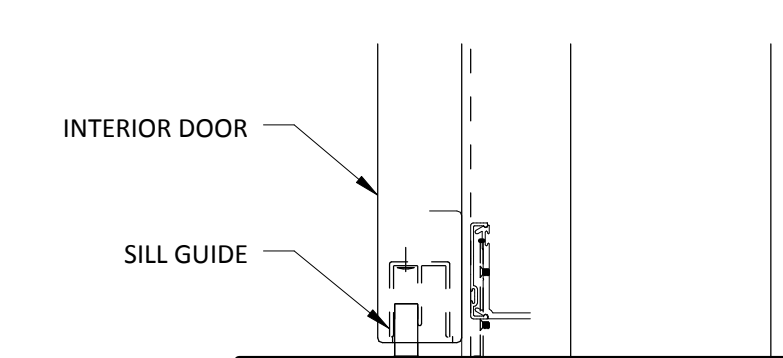


20 BARN DOOR @ SILL

A8.2 | A8.2 3" = 1'-0"

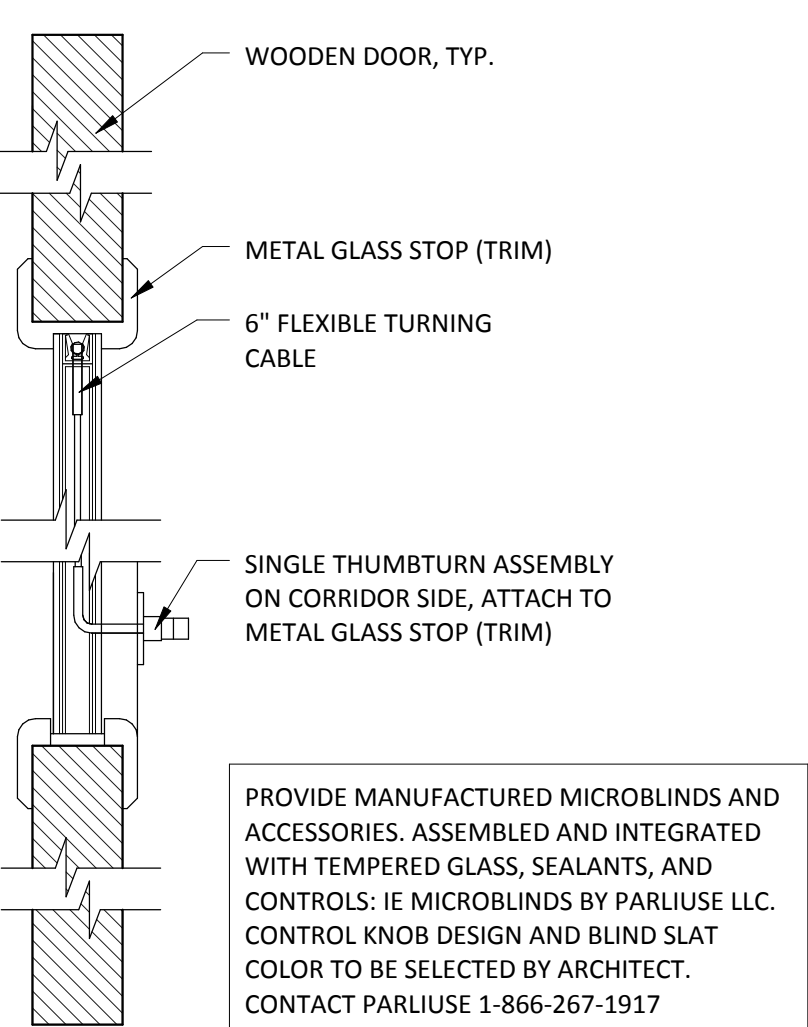


4 SECTION @ INTEGRAL BLINDS

A8.2 | A8.2 3" = 1'-0"

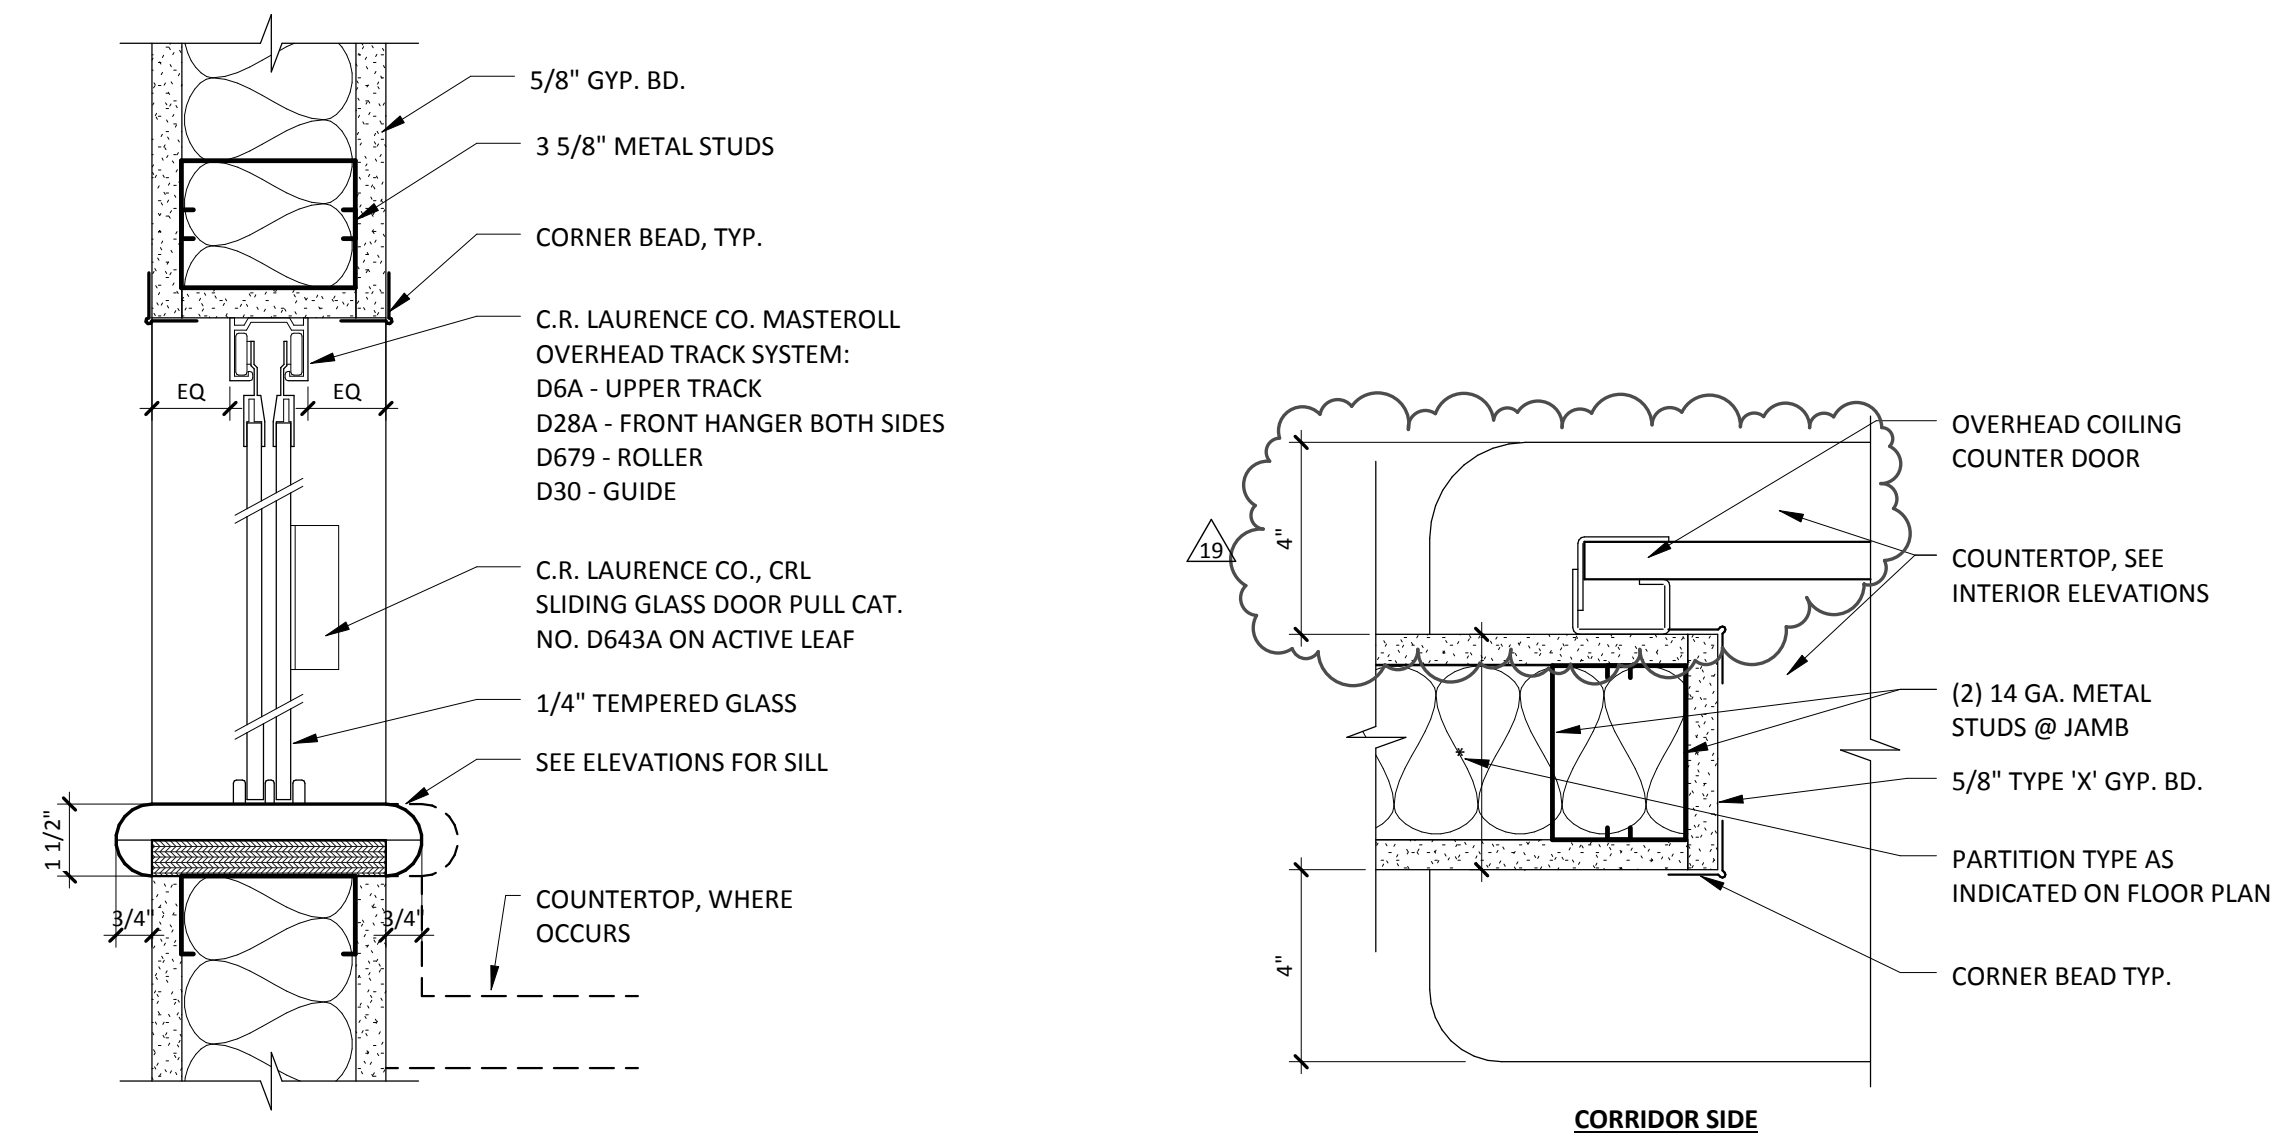


15 SLIDING GLASS WINDOW DETAIL

A8.2 | A8.2 3" = 1'-0"

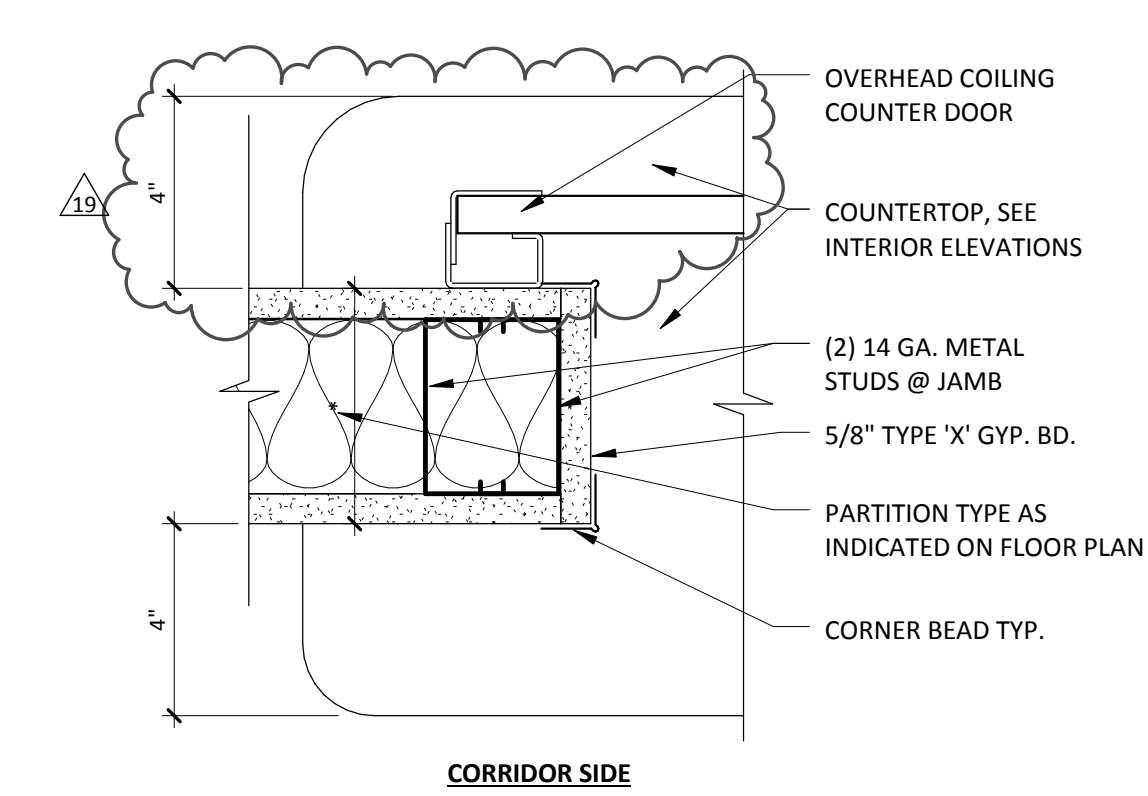


16 OVERHEAD COILING DOOR @ JAMB

A6.4 | A8.2 3" = 1'-0"

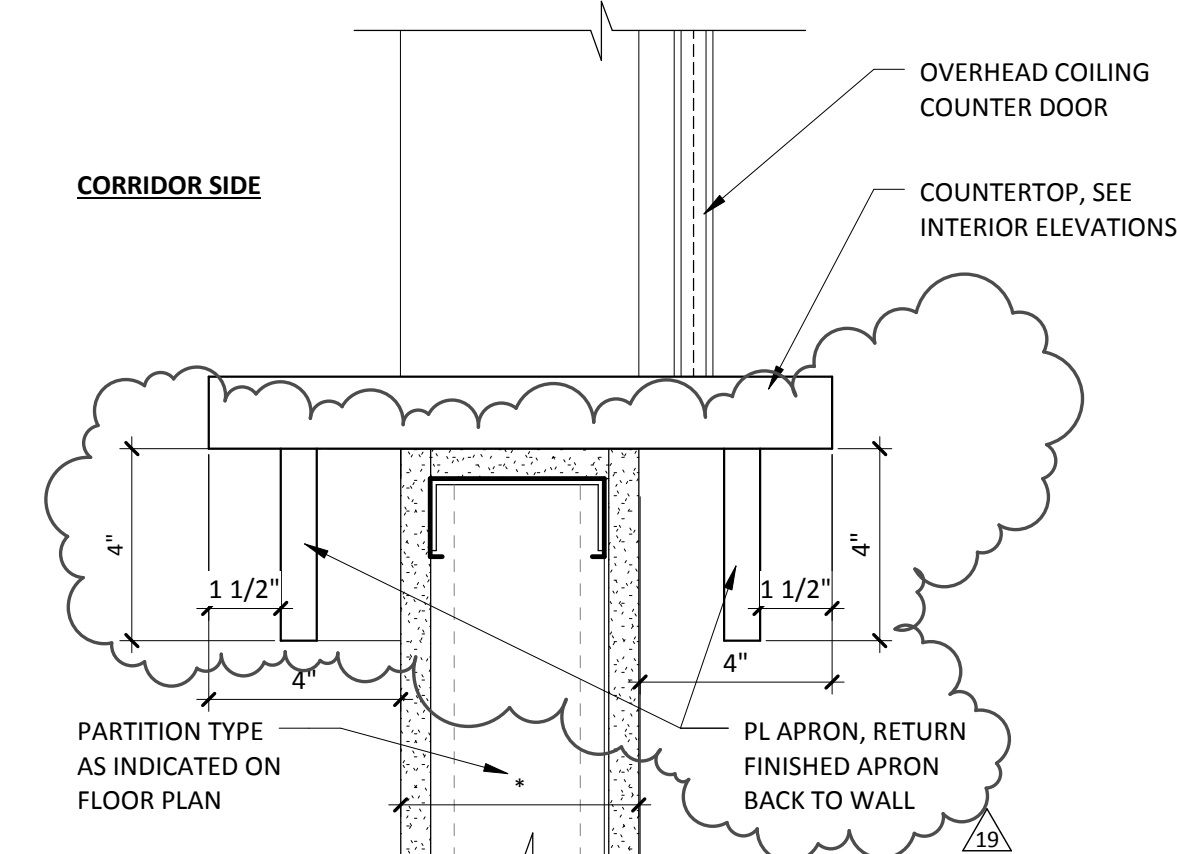

18 OVERHEAD COILING DOOR @ SILL


A6.4 | A8.2 3" = 1'-0"

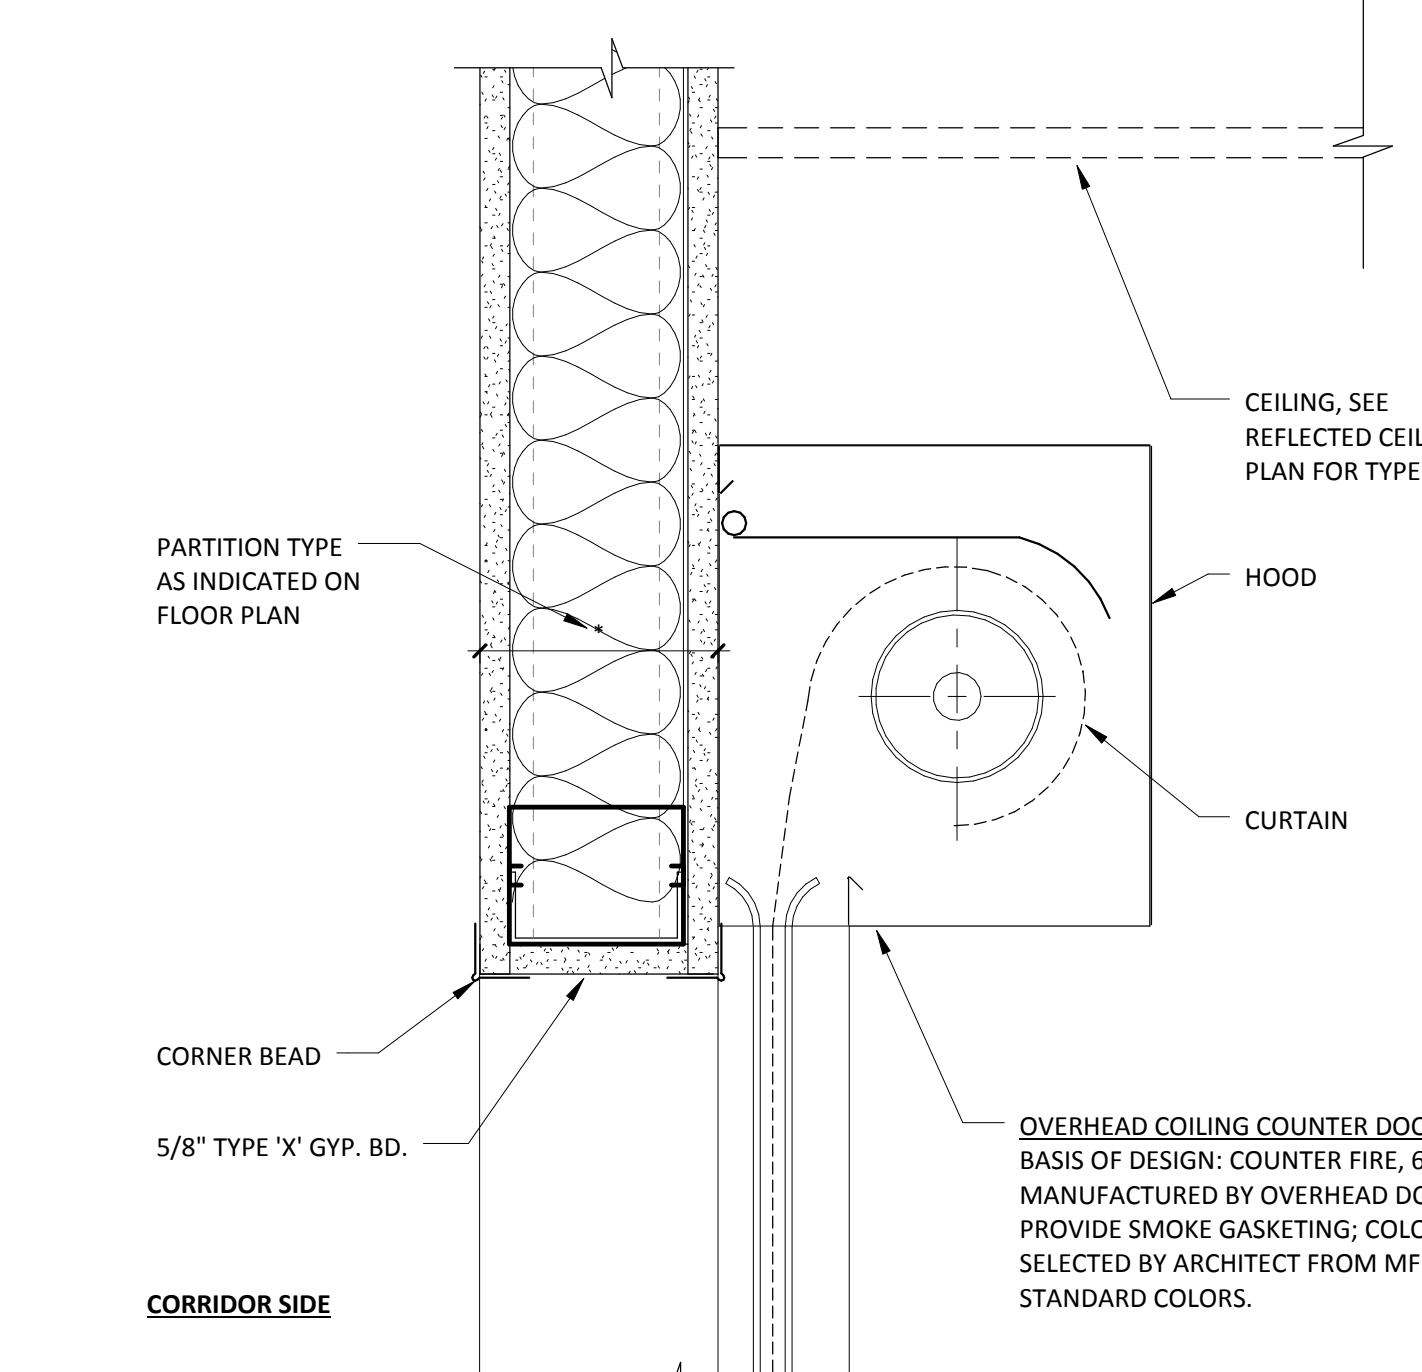

3 OVERHEAD COILING DOOR @ HEADER

A6.4 | A8.2 3" = 1'-0"

C:\Users\mbaser\Documents\132258.00 A13 Ceiling.mbaaser.rvt
TTLBv:111101 3/18/2014 5:21:55 PM

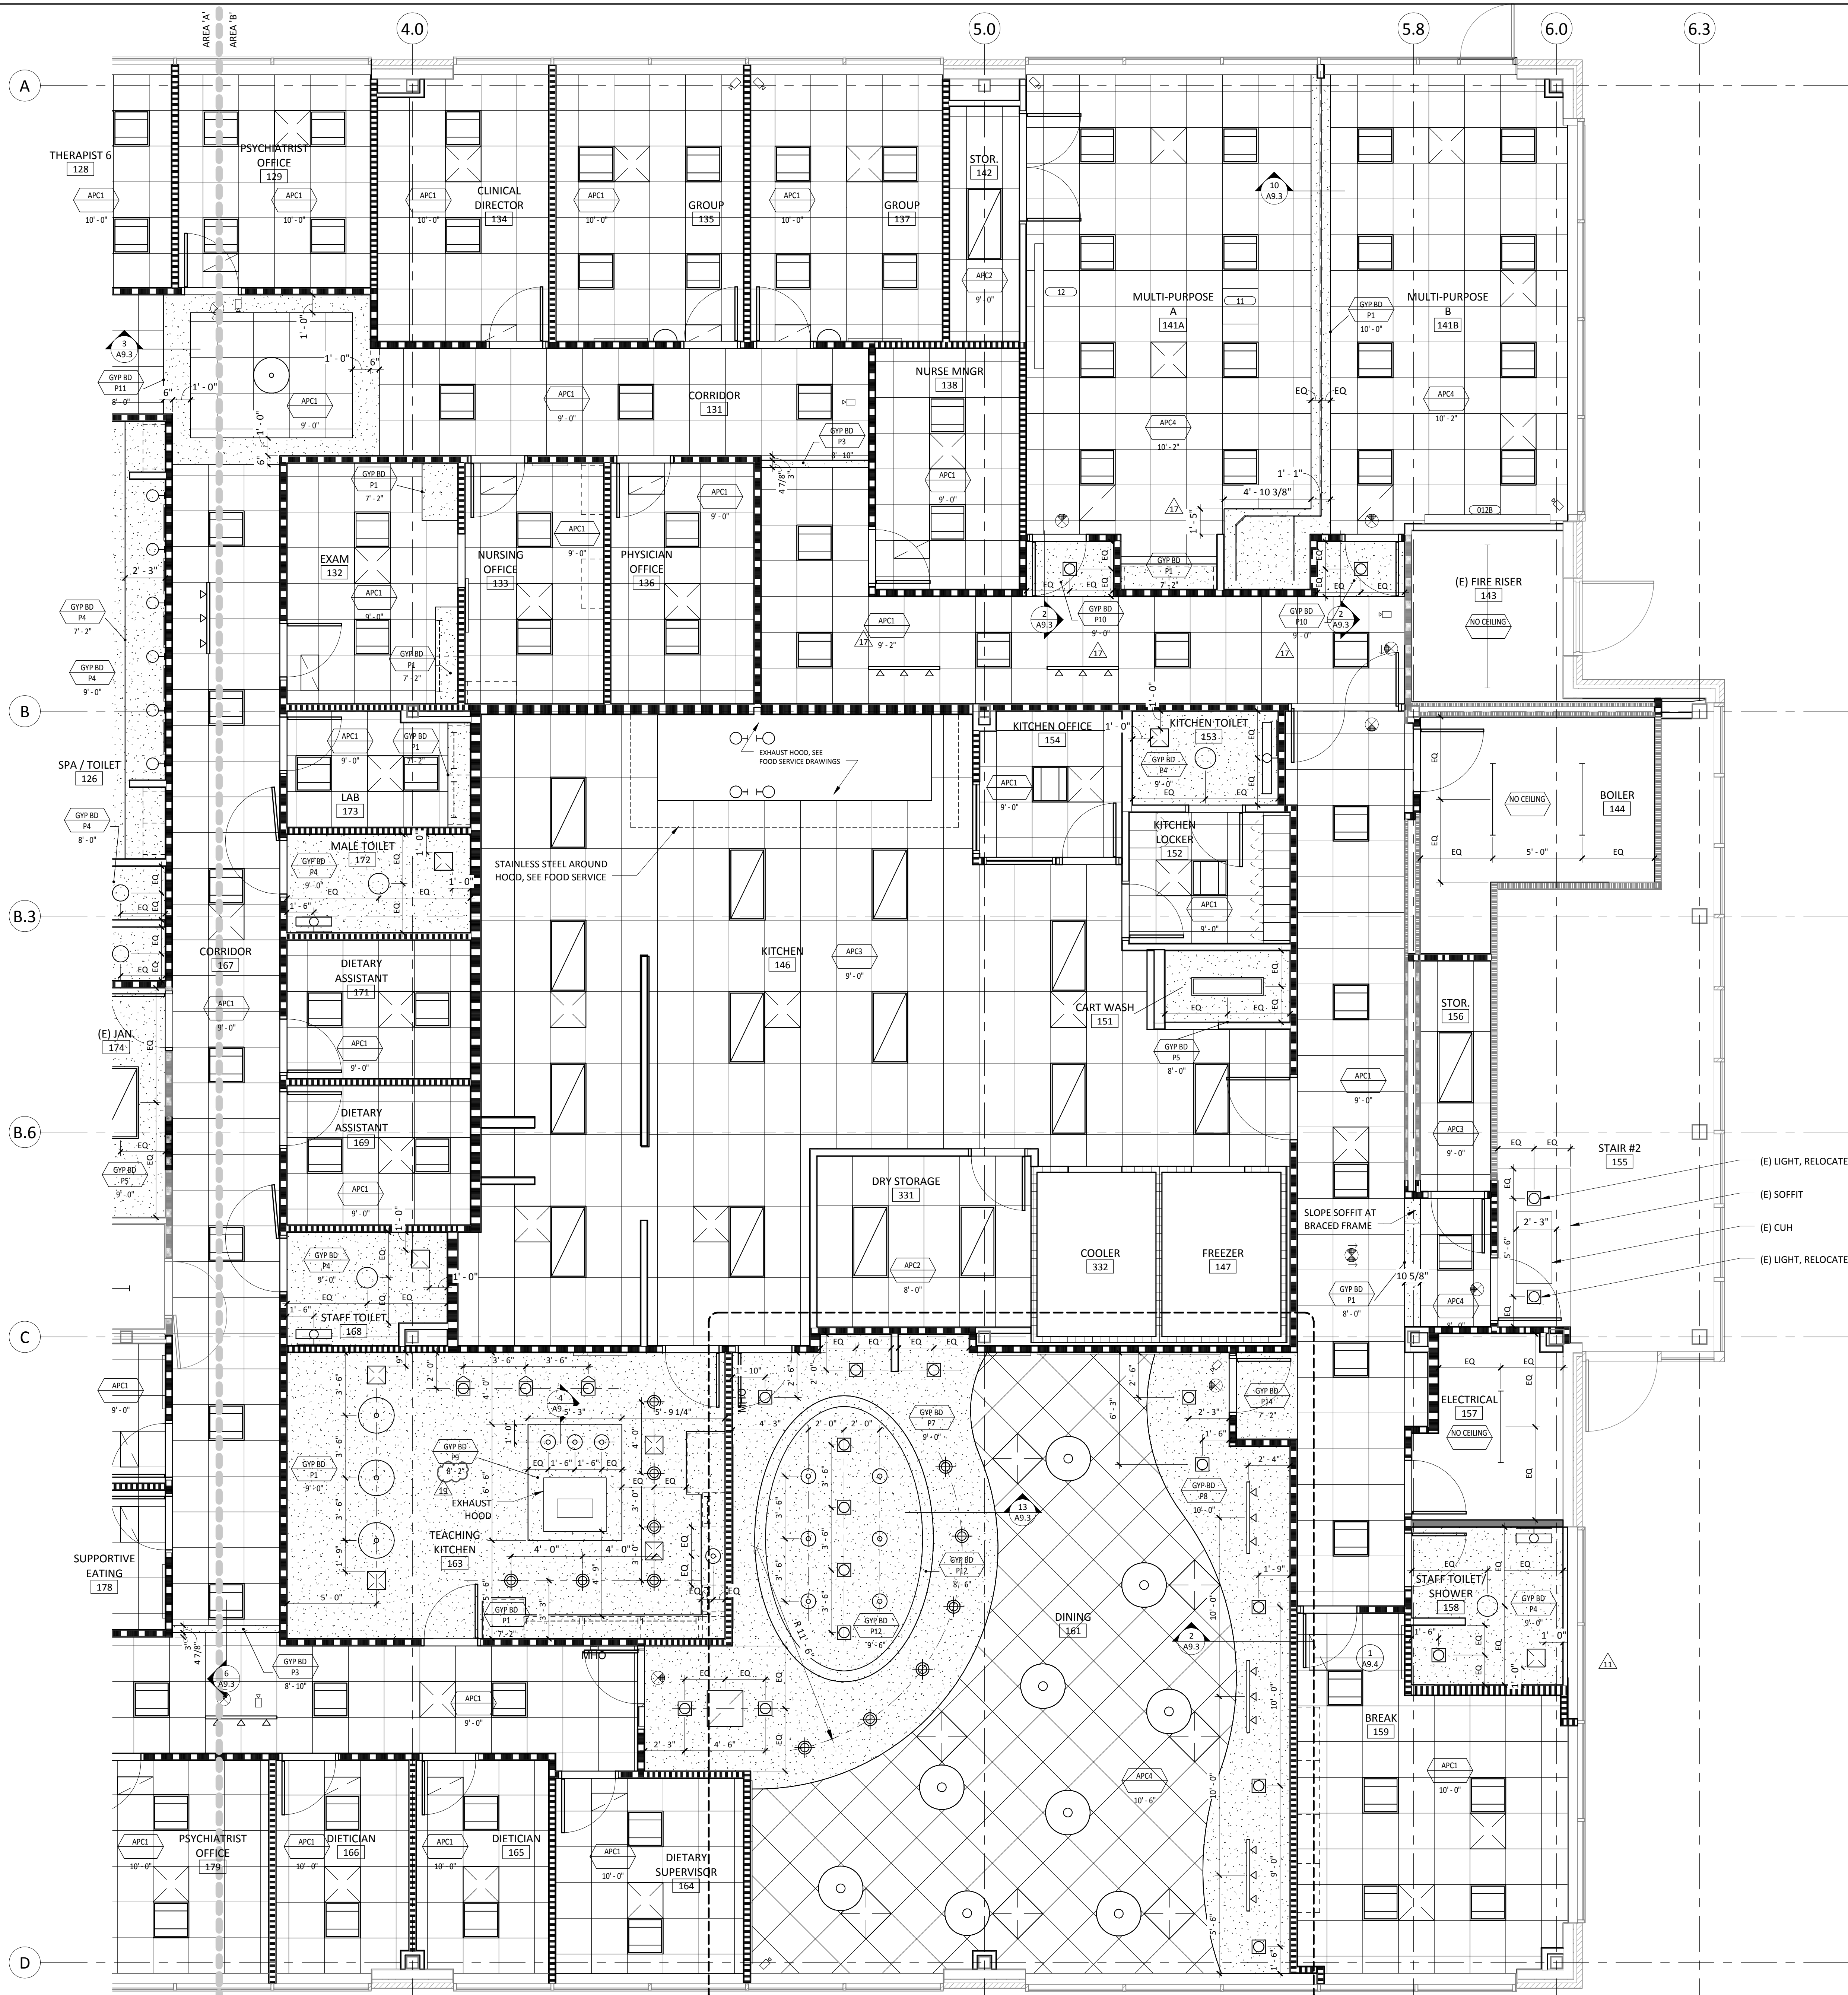

CEILING LEGEND


SYMBOL	DESCRIPTION
	RECESSED DOWNLIGHT FIXTURE W/ HORIZONTAL COMPACT FLUORESCENT LAMP. 'D' INDICATES DIMMING BALLAST & SWITCH.
	RECESSED WALL WASHER FIXTURE W/ HORIZONTAL COMPACT FLUORESCENT LAMP. 'D' INDICATES DIMMING BALLAST & SWITCH.
	RECESSED WALL WASHER FIXTURE W/ HALOGEN LAMP. 'D' INDICATES DIMMING SWITCH.
	RECESSED FLUORESCENT INDIRECT LIGHT FIXTURE - 2x2 OR 2x4 AS INDICATED
	RECESSED PRISMATIC LENS FLUORESCENT LIGHT FIXTURE - 2x2 OR 2x4 AS INDICATED
	RECESSED PARABOLIC LENS FLUORESCENT LIGHT FIXTURE - 2x2 OR 2x4 AS INDICATED
	SURFACE MOUNTED PRISMATIC LENS FLUORESCENT LIGHT FIXTURE - 1x4
	WALL-MOUNTED FLUORESCENT LIGHT BRACKET
	WALL SCONCE LIGHT FIXTURE
	WALL SCONCE LIGHT FIXTURE
	FLUORESCENT LIGHT STRIP
	UNDERCABINET FLUORESCENT LIGHT
	RECESSED FLUORESCENT LINEAR LIGHT FIXTURE
	LARGE DECORATIVE PENDANT LIGHT FIXTURE
	SMALL DECORATIVE PENDANT LIGHT FIXTURE
	SURFACE MOUNTED LIGHT FIXTURE
	RECESSED DOWNLIGHT FIXTURE W/ DECORATIVE GLASS LENSE
	TRACK MOUNTED ART LIGHTING
	EXIT SIGN
	GYP. BOARD CONTROL JOINT
	SUPPLY DIFFUSER - SEE MECHANICAL
	RETURN GRILLE - SEE MECHANICAL
	EXHAUST - SEE MECHANICAL
	SECURITY CAMERA - LOW VOLTAGE
	ACOUSTIC PANEL CEILING - 2x2 OR 2x4 AS INDICATED.
	GYP. BD. CEILING
	WOOD SLAT CEILING

GENERAL CEILING NOTES

- GENERAL CEILING PAINT SHALL BE P3 UNLESS NOTED OTHERWISE.
- PAINT INDICATED FOR SOFFITS SHALL WRAP ALL EXPOSED SURFACES OF SOFFIT, UNLESS NOTED OTHERWISE.
- ALL SIDES OF SOFFIT ABOVE UPPER CABINETRY SHALL BE PAINTED TO MATCH ADJACENT WALL FINISH, UNLESS NOTED OTHERWISE.
- REFER TO MATERIALS LIST ON ID SHEET FOR PAINT SPECIFICATIONS.

CEILING TYPES			
TYPE	DESCRIPTION	MFR.	STYLE/ REMARKS
APC1	ACOUSTIC PANEL CEILING	CERTAINTED	SAND MICRO SHM-124, 24" X 24" X 5/8" LAY-IN REVEAL EDGE (BEVELED) 15/16" GRID, WHITE
APC2	ACOUSTIC PANEL CEILING	CERTAINTED	FINE FISSURED HHF-194, 24" X 48" X 5/8" LAY-IN REVEAL EDGE (BEVELED) 15/16" GRID, WHITE
APC3	ACOUSTIC PANEL CEILING	CERTAINTED	VINYLROCK 1140-CRF-1, 24" X 48" X 1/2" TRIM EDGE WITH CLEAN ROOM GRID 15/16", HOLD DOWN CLIPS, WHITE
APC4	ACOUSTIC PANEL CEILING	CERTAINTED	PERFORMA 1342-10F-1, 24" X 24" X 1", LAY-IN REVEAL EDGE (BEVELED) 15/16" GRID, WHITE
GYP BD	PAINTED GYP. BD. CEILING		
NO CEILING			
WDC1	WOOD CEILING	ARMSTRONG	WOODWORKS SLAT CEILING, LIGHT CHERRY 4" SLATS.
WDC2	WOOD CEILING	ARMSTRONG	WOODWORKS SLAT CEILING, LIGHT CHERRY 6" SLATS.

KEYPLAN - AREA 'B'

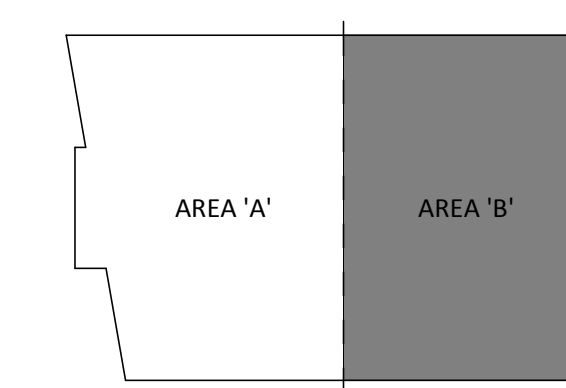

PROJECT NUMBER
132258.00

DRAWN BY
K. Schuermann

DATE
NOVEMBER 26, 2013

REVISIONS		
REV.	DESCRIPTION	DATE
2	Addendum #2	12.10.13
4	Addendum #3	01.15.2014
11	PR #3	02.11.2014
17	ASI #03	02.21.2014
18	PR-08	03.13.2014
19	PR-09	3.18.2014

BOULDER ASSOCIATES

ARCHITECTS

Boulder Associates, Inc.
Architecture + Interior Design
1426 Pearl Street, Suite 300
Boulder, Colorado 80302
303.499.7795 F 303.499.7767
www.boulderassociates.com


PROJECT
ERC RESIDENTIAL PROGRAM & PHP

98 Spruce Street
Denver, CO 80230

SHEET TITLE
FLOOR 1 - REFLECTED CEILING PLAN AREA 'B'

SHEET NUMBER

A9.1B

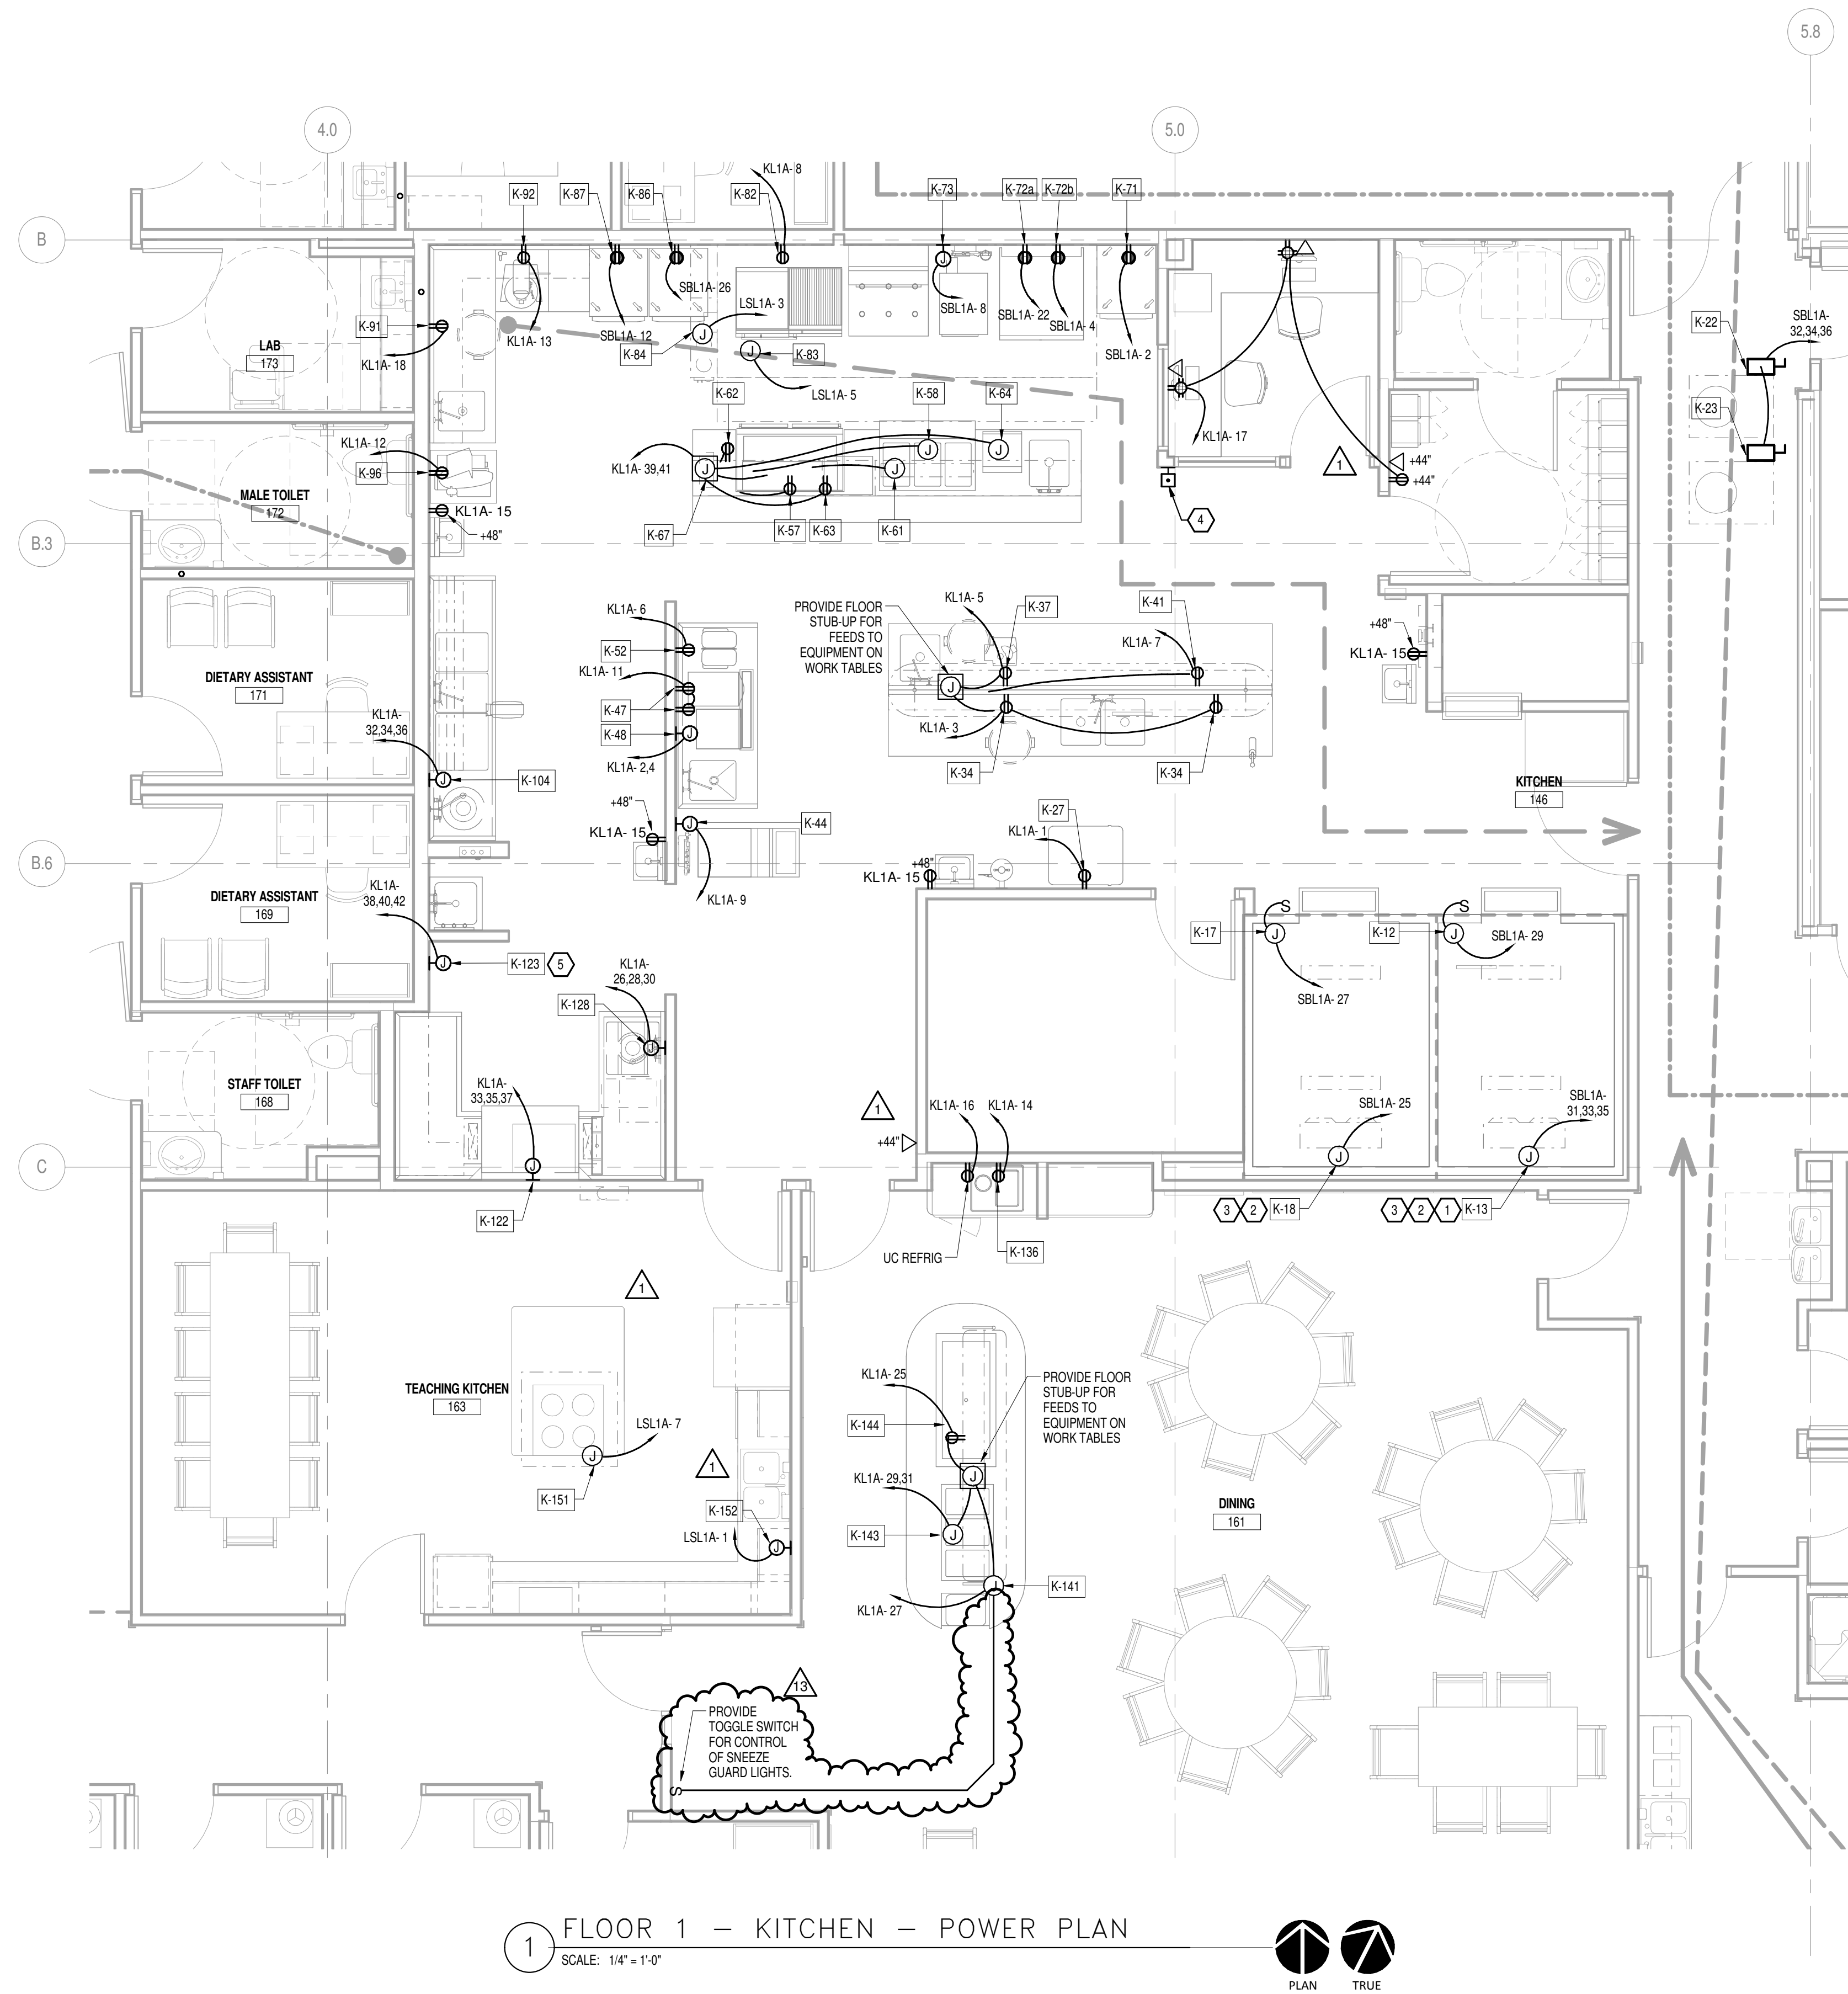

SHEET NOTES

1. EQUIPMENT SHOWN IS NEW UNLESS OTHERWISE INDICATED.
2. PROVIDE DEDICATED NEUTRAL CONDUCTOR FOR EACH 120V CIRCUIT.
3. REFERENCE FOOD SERVICE DRAWINGS FOR ADDITIONAL INFORMATION.
4. 120V RECEPTACLES THIS SHEET SHALL BE 20 AMPERE WITH INDIVIDUAL INTEGRAL GFCI TYPE UNLESS OTHERWISE NOTED.

KEY NOTES

1. ELECTRICAL CONTRACTOR TO INTERCONNECT FIVE #12 WIRES FROM COIL FAN TO FREEZER COMPRESSOR FOR DEFROST CYCLE.
2. ELECTRICAL CONTRACTOR TO INTERCONNECT WIRING FROM BLOWER COIL TO COMPRESSOR FOR TEMPERATURE SENSOR ON ALL COOLERS AND FREEZERS.
3. ELECTRICAL CONTRACTOR TO CONNECT ALL REFRIGERATION SYSTEM AND WALK-IN BOX COMPONENTS TO BUILDING EMERGENCY POWER SYSTEM.
4. LOCATION OF MANUAL FIRE SUPPRESSION PULL STATION. ELECTRICAL CONTRACTOR SHALL PROVIDE OCTAGON BOX AND RUN EMPTY 1\"/>

PROJECT NUMBER
132258.00

DRAWN BY
N. Paugh

DATE
November 26, 2013

REVISIONS	DESCRIPTION	DATE
1	ADDENDUM 1	12.04.13
13	PR-09	03.12.2014



BOULDER ASSOCIATES

ARCHITECTS

Boulder Associates, Inc.
Architecture + Interior Design
1426 Pearl Street, Suite 300
Boulder, Colorado 80302
303.499.7795 F 303.499.7767
www.boulderassociates.com

PROJECT
ERC RESIDENTIAL PROGRAM & PHP

98 Spruce Street
Denver CO 80230

SHEET TITLE
FLOOR 1 - KITCHEN - POWER PLAN

SHEET NUMBER

E4.1